



CONCEPT

T H E R  
ARCHITECTURAL STUDIO

ČSA 474, CHRUDIM, 537 01  
CZECH REPUBLIC  
GSM: +420 603 807 027

INVESTOR:

BUILDING:  
APARTMENT No93  
WHITEHALL COURT  
LONDON

PHASE:  
CONCEPT – BUILDING DESIGN

ARCH. DESIGN:  
ING. ARCH. KAREL THÉR

AUTHORIZATION:  
ING. ARCH. KAREL THÉR

DESIGNED BY:  
KLÁRA THÉROVÁ  
LUBOMÍR KROV, INC. ARCH. TOMÁŠ KONDRA

DATE:  
10. 2011  
SET:  
10. 2011

SCALE:  
1:100


FORMAT:  
A1

DRAWNING NO.:  
0167-NS

0167-NS



PLAN

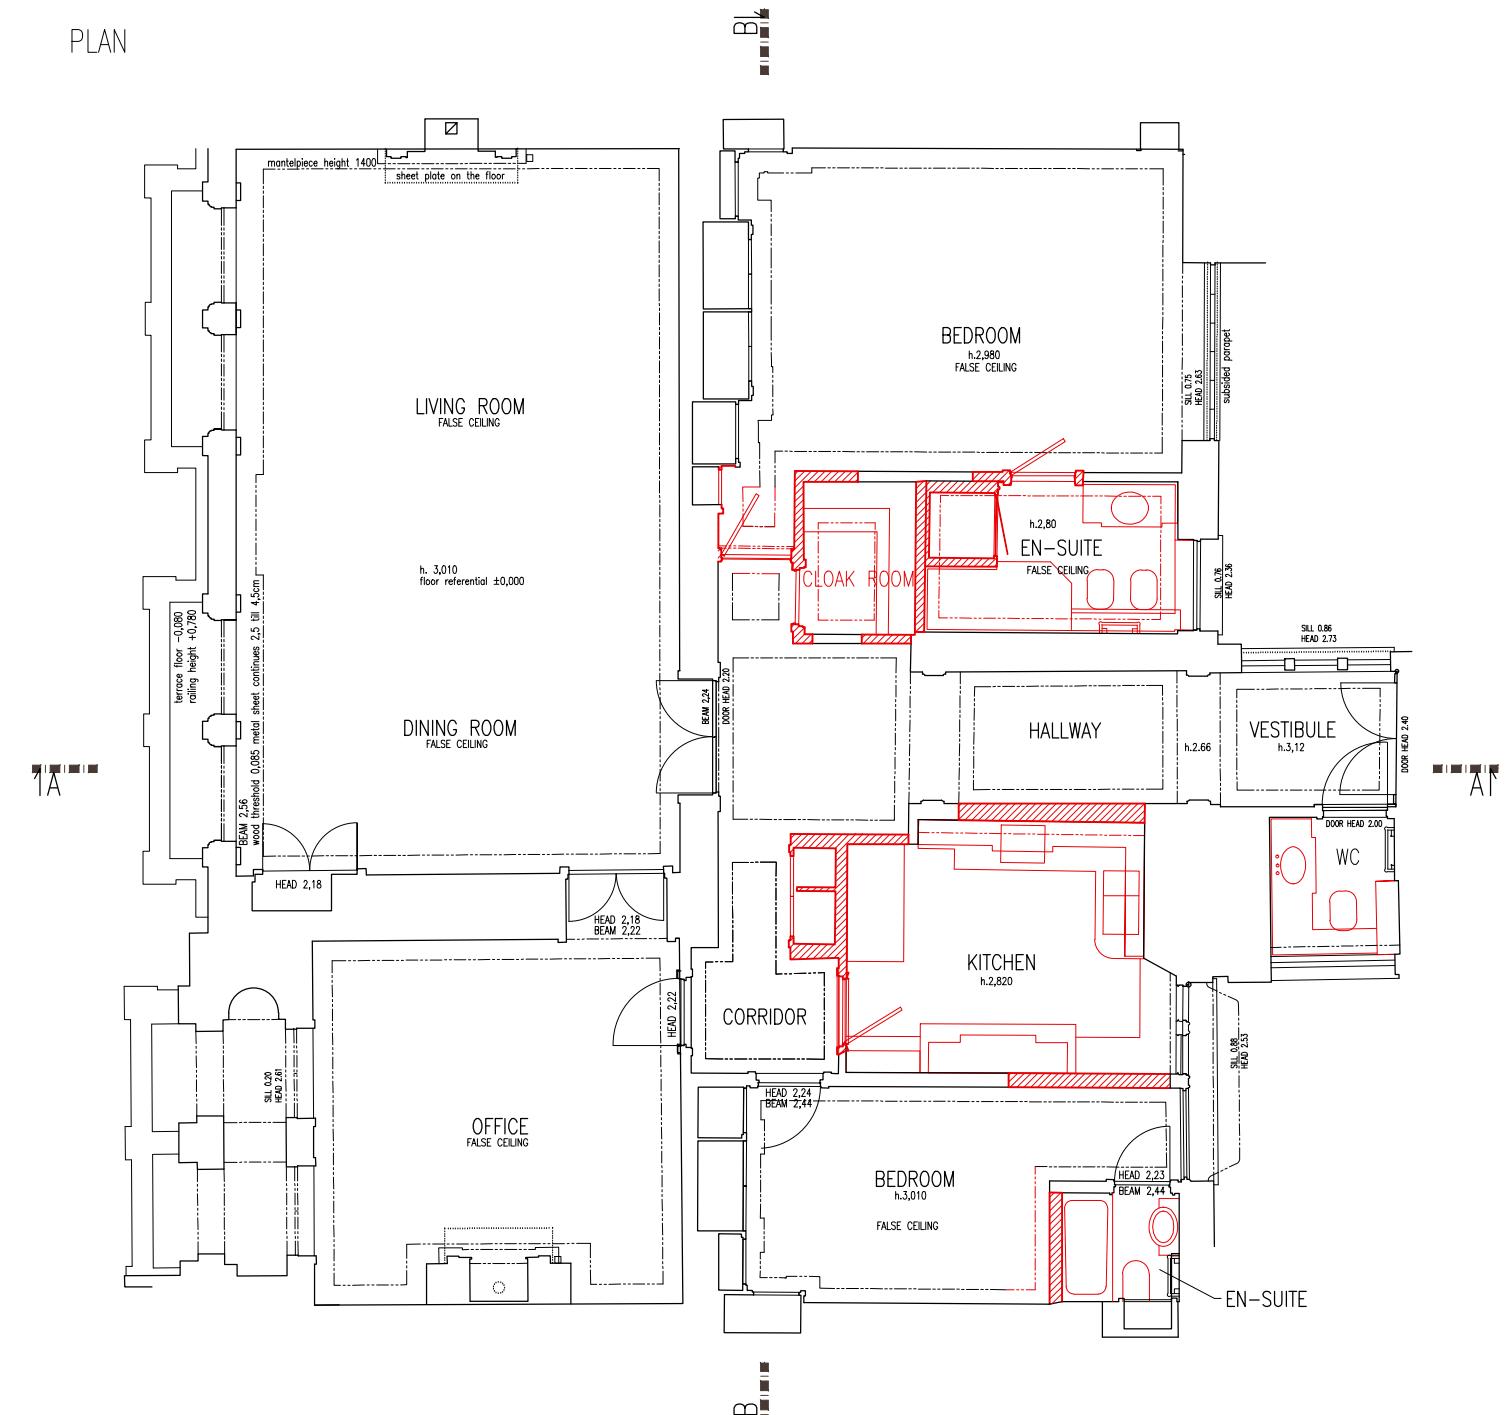

**T H E R**  
ARCHITECTURAL STUDIO

ČSA 474, CHRUDIM, 537 01  
CZECH REPUBLIC  
GSM: +420 603 807 027

---

**CLIENT:**

BUILDING: APARTMENT No93  
WHITEHALL COURT  
LONDON

ANNEX: EXISTING PLANS  
AS-BUILT FLOOR PLAN

## PHASE: CONCEPT – BUILDING DESIGN

ARCH. DESIGN: ING. ARCH. KAREL THÉR

**PROFESSION:** EXISTING PLANS

AUTHORIZATION: ING. ARCH. KAREL THÉR

DESIGNED BY:  
ĽUBOMÍR KROV. ING. ARCH. TOMÁŠ KONDRAŠ

DATE: SET:  
10. 2011

SCALE: 1 : 100



FORMAT: A7

DRAWING NO.: 0167 NS

AP 100

AB 100

PLAN

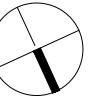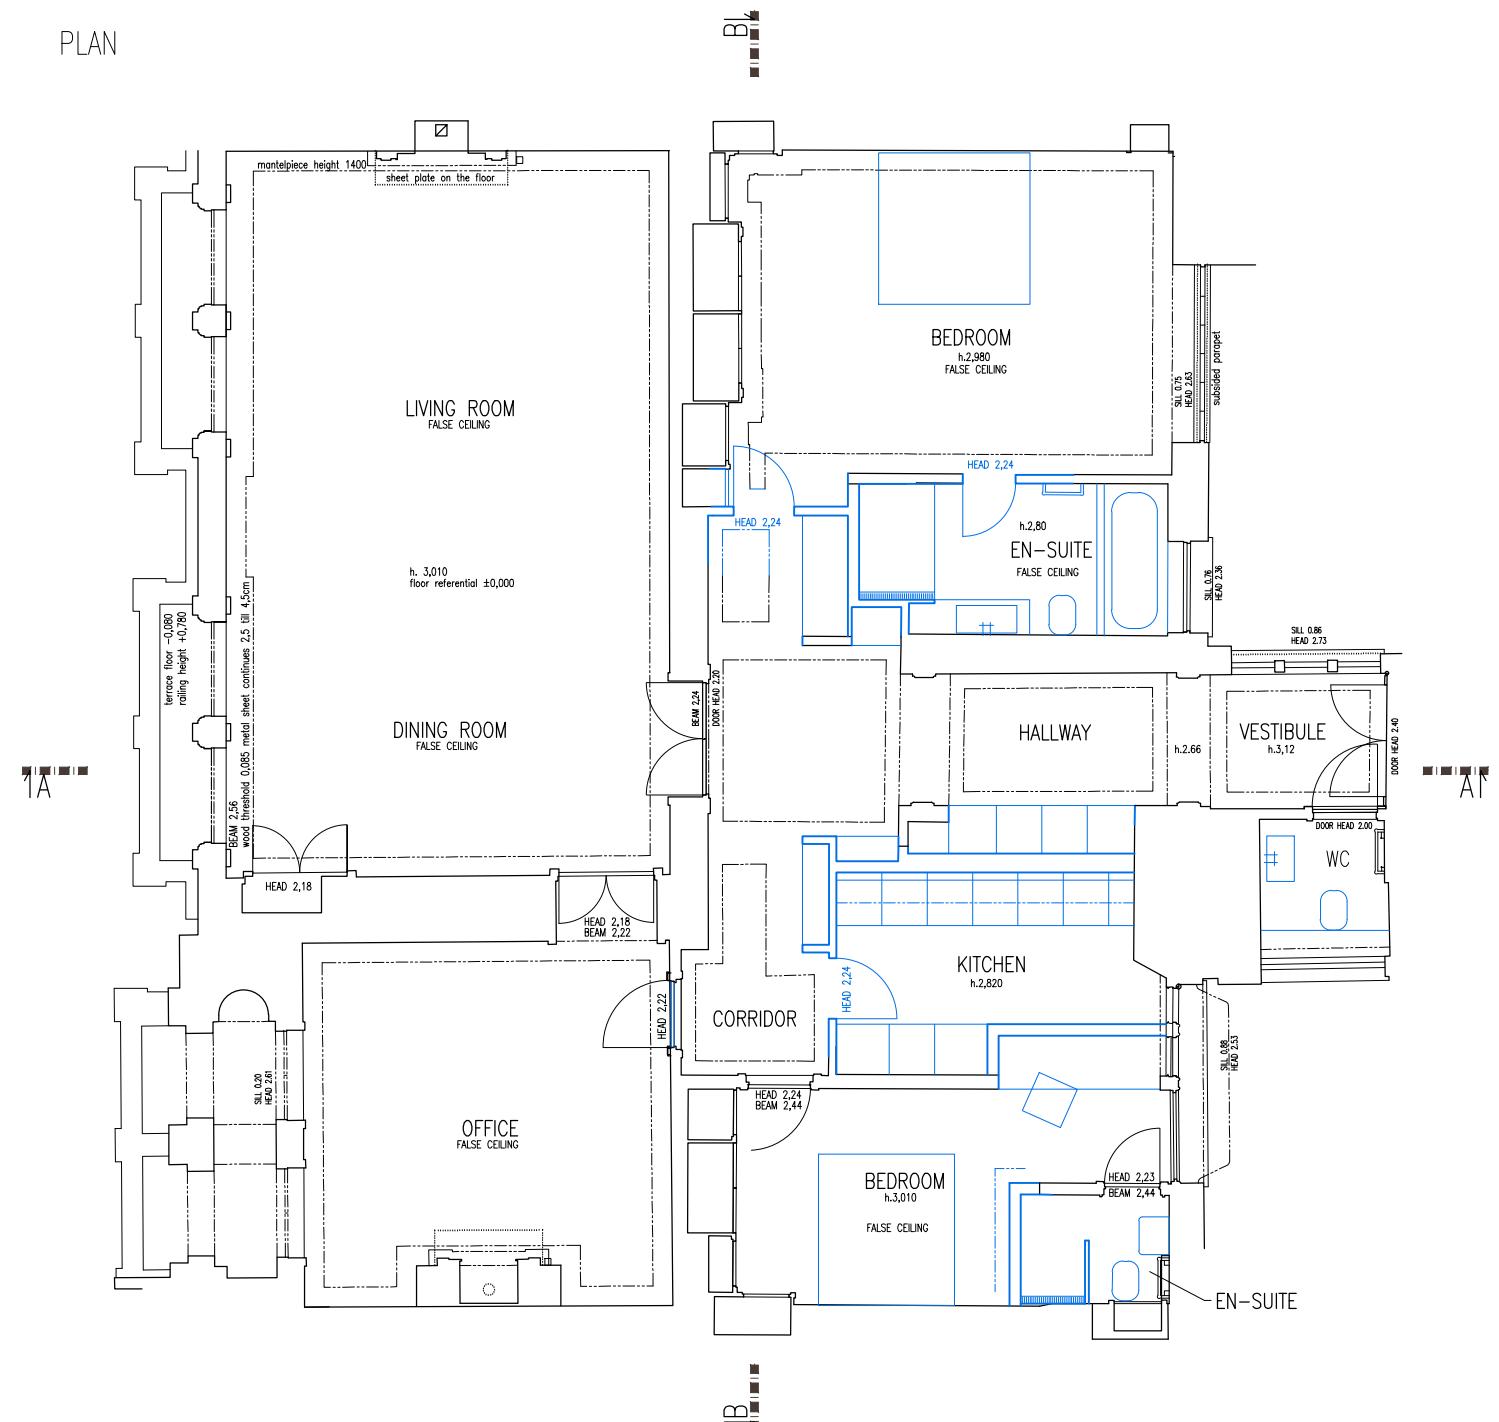

T H E R  
ARCHITECTURAL STUDIO

ČSA 474, CHRUDIM, 537 01  
CZECH REPUBLIC  
GSM: +420 603 807 027

INVESTOR:

BUILDING:  
APARTMENT No93  
WHITEHALL COURT  
LONDON

ANNEX:  
PROPOSED PLANS  
CONCEPT FLOOR PLAN

PHASE:  
CONCEPT - BUILDING DESIGN

ARCH. DESIGN:  
ING. ARCH. KAREL THÉR

PROFESSION:  
ARCHITECTONIC-CONSTRUCTION

AUTHORIZATION:  
ING. ARCH. KAREL THÉR

DESIGNED BY:  
ING. ARCH. KAREL THÉR

ING. ARCH. TOMÁŠ KONDRA



DATE:  
10. 2011



SCALE:  
1 : 100

FORMAT:  
A3

DRAWING NO.:  
0167-NS

PP - 100

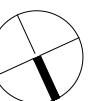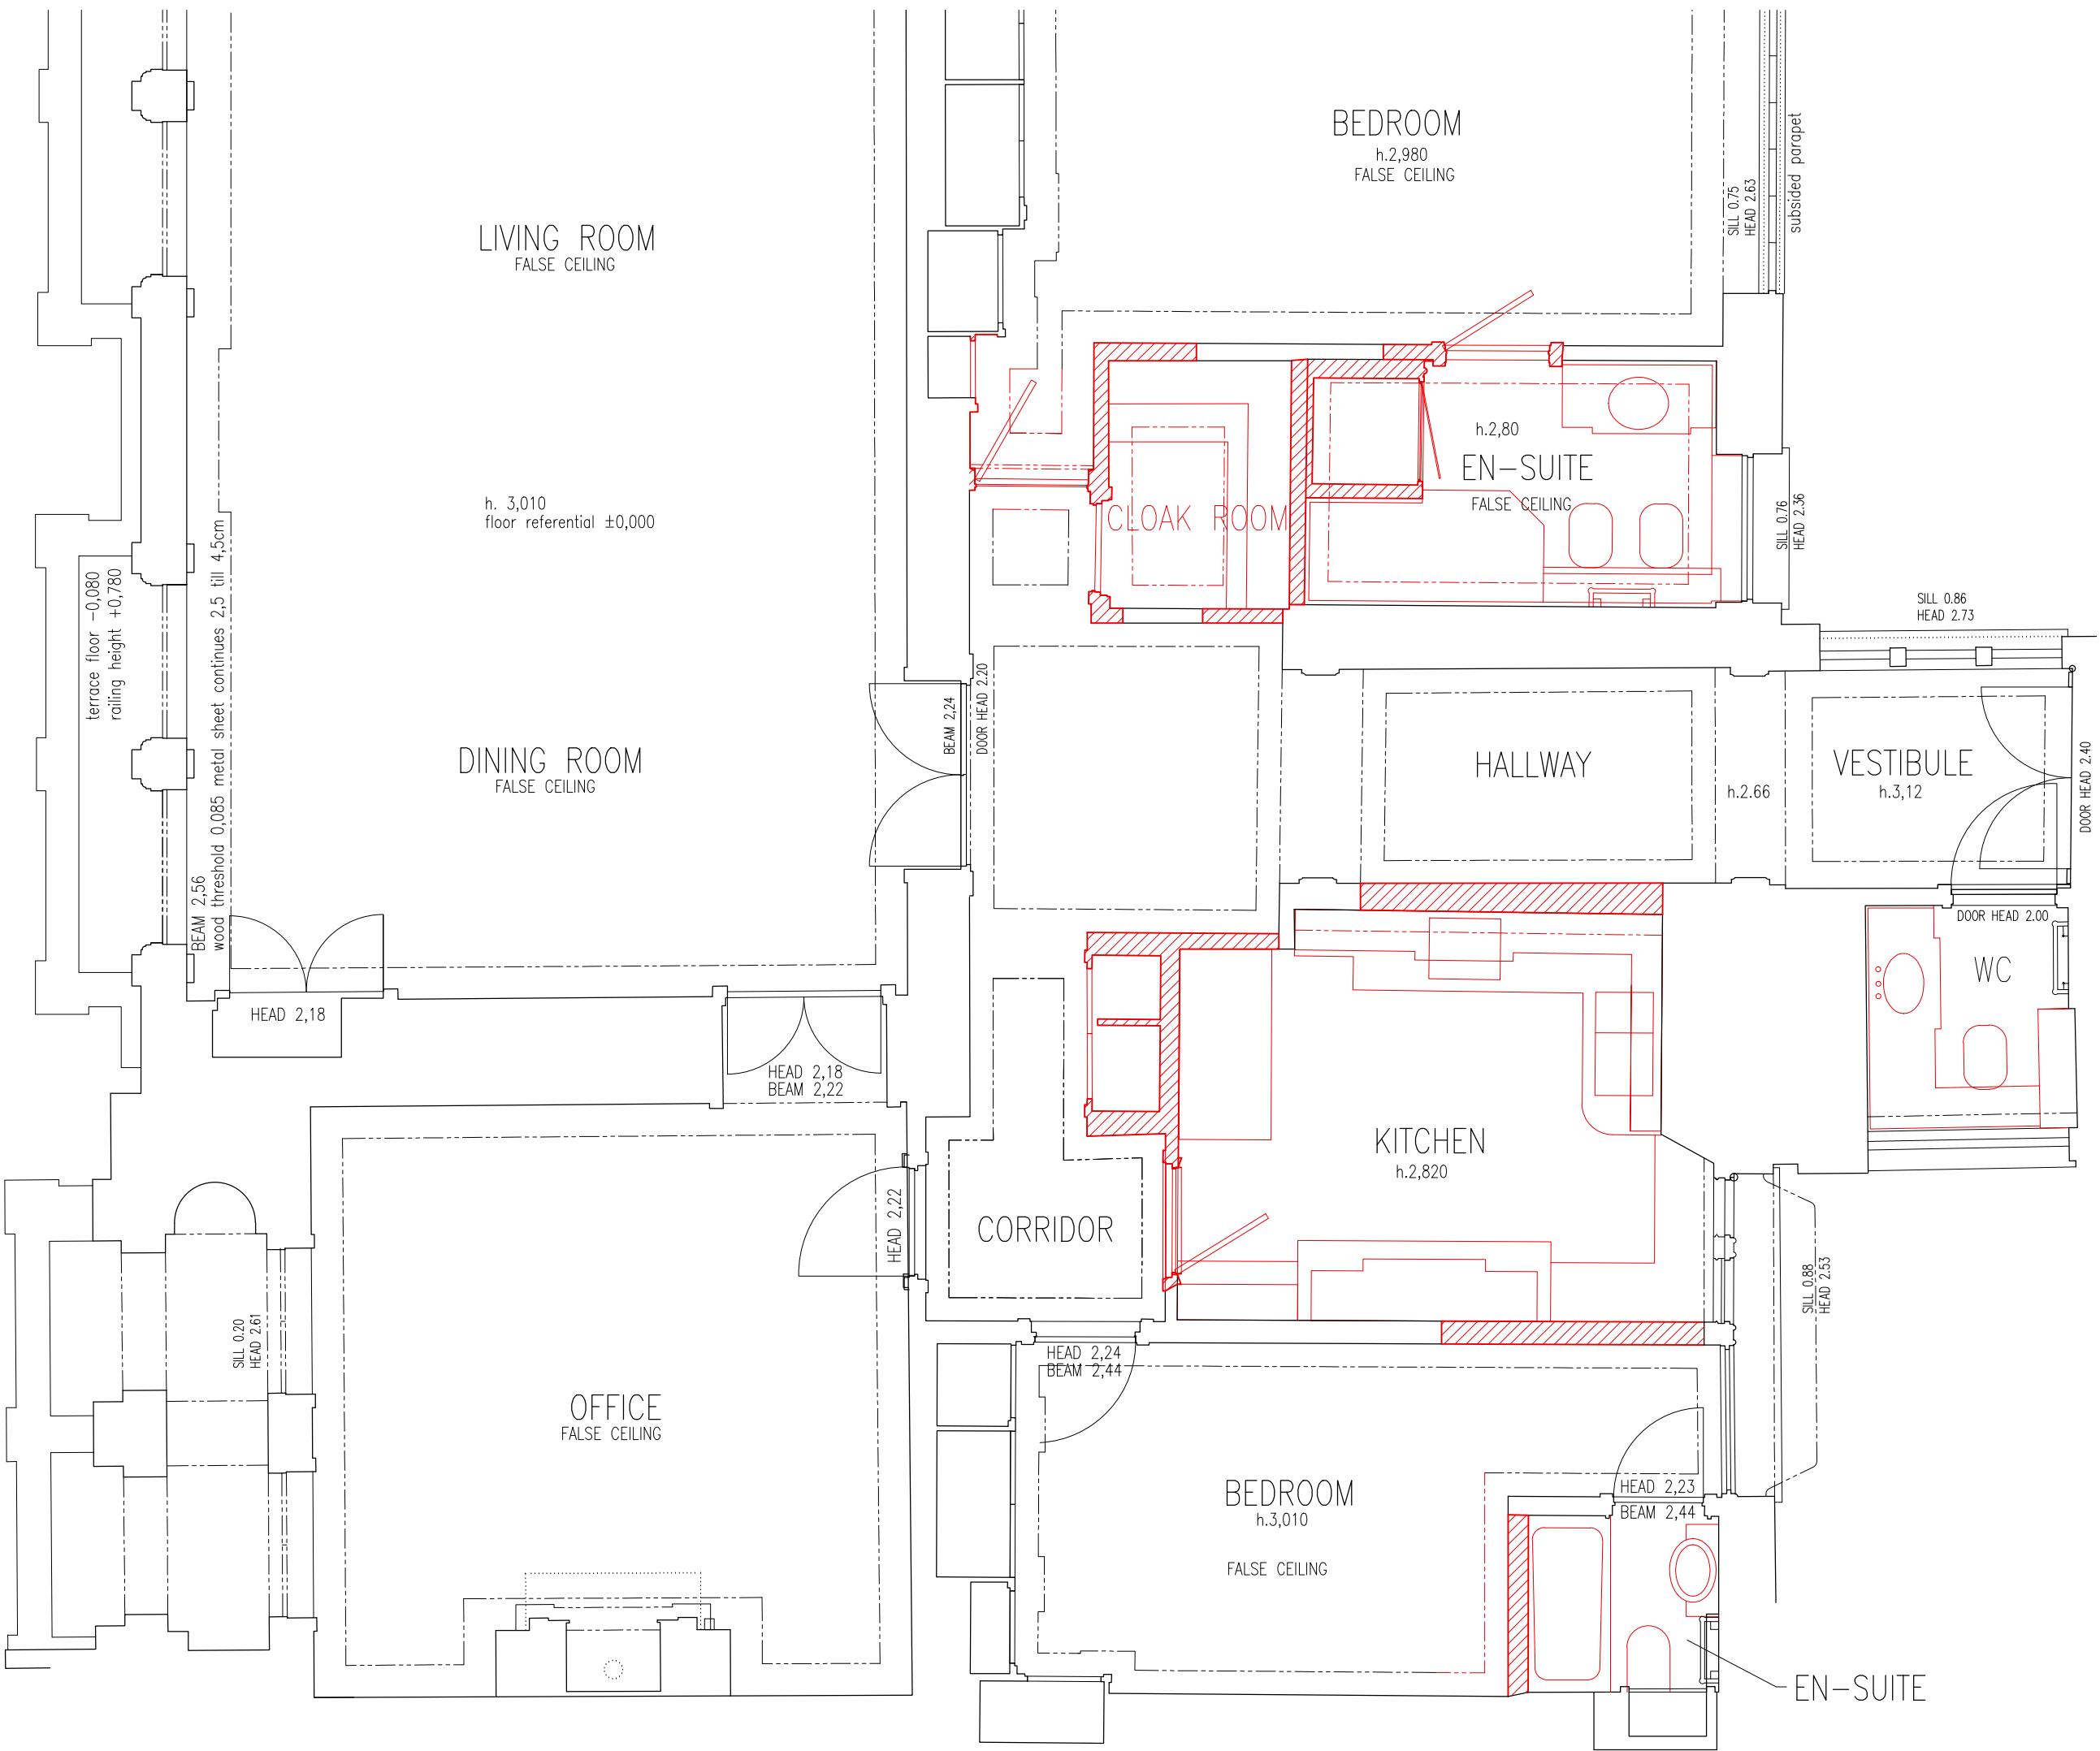

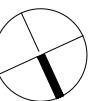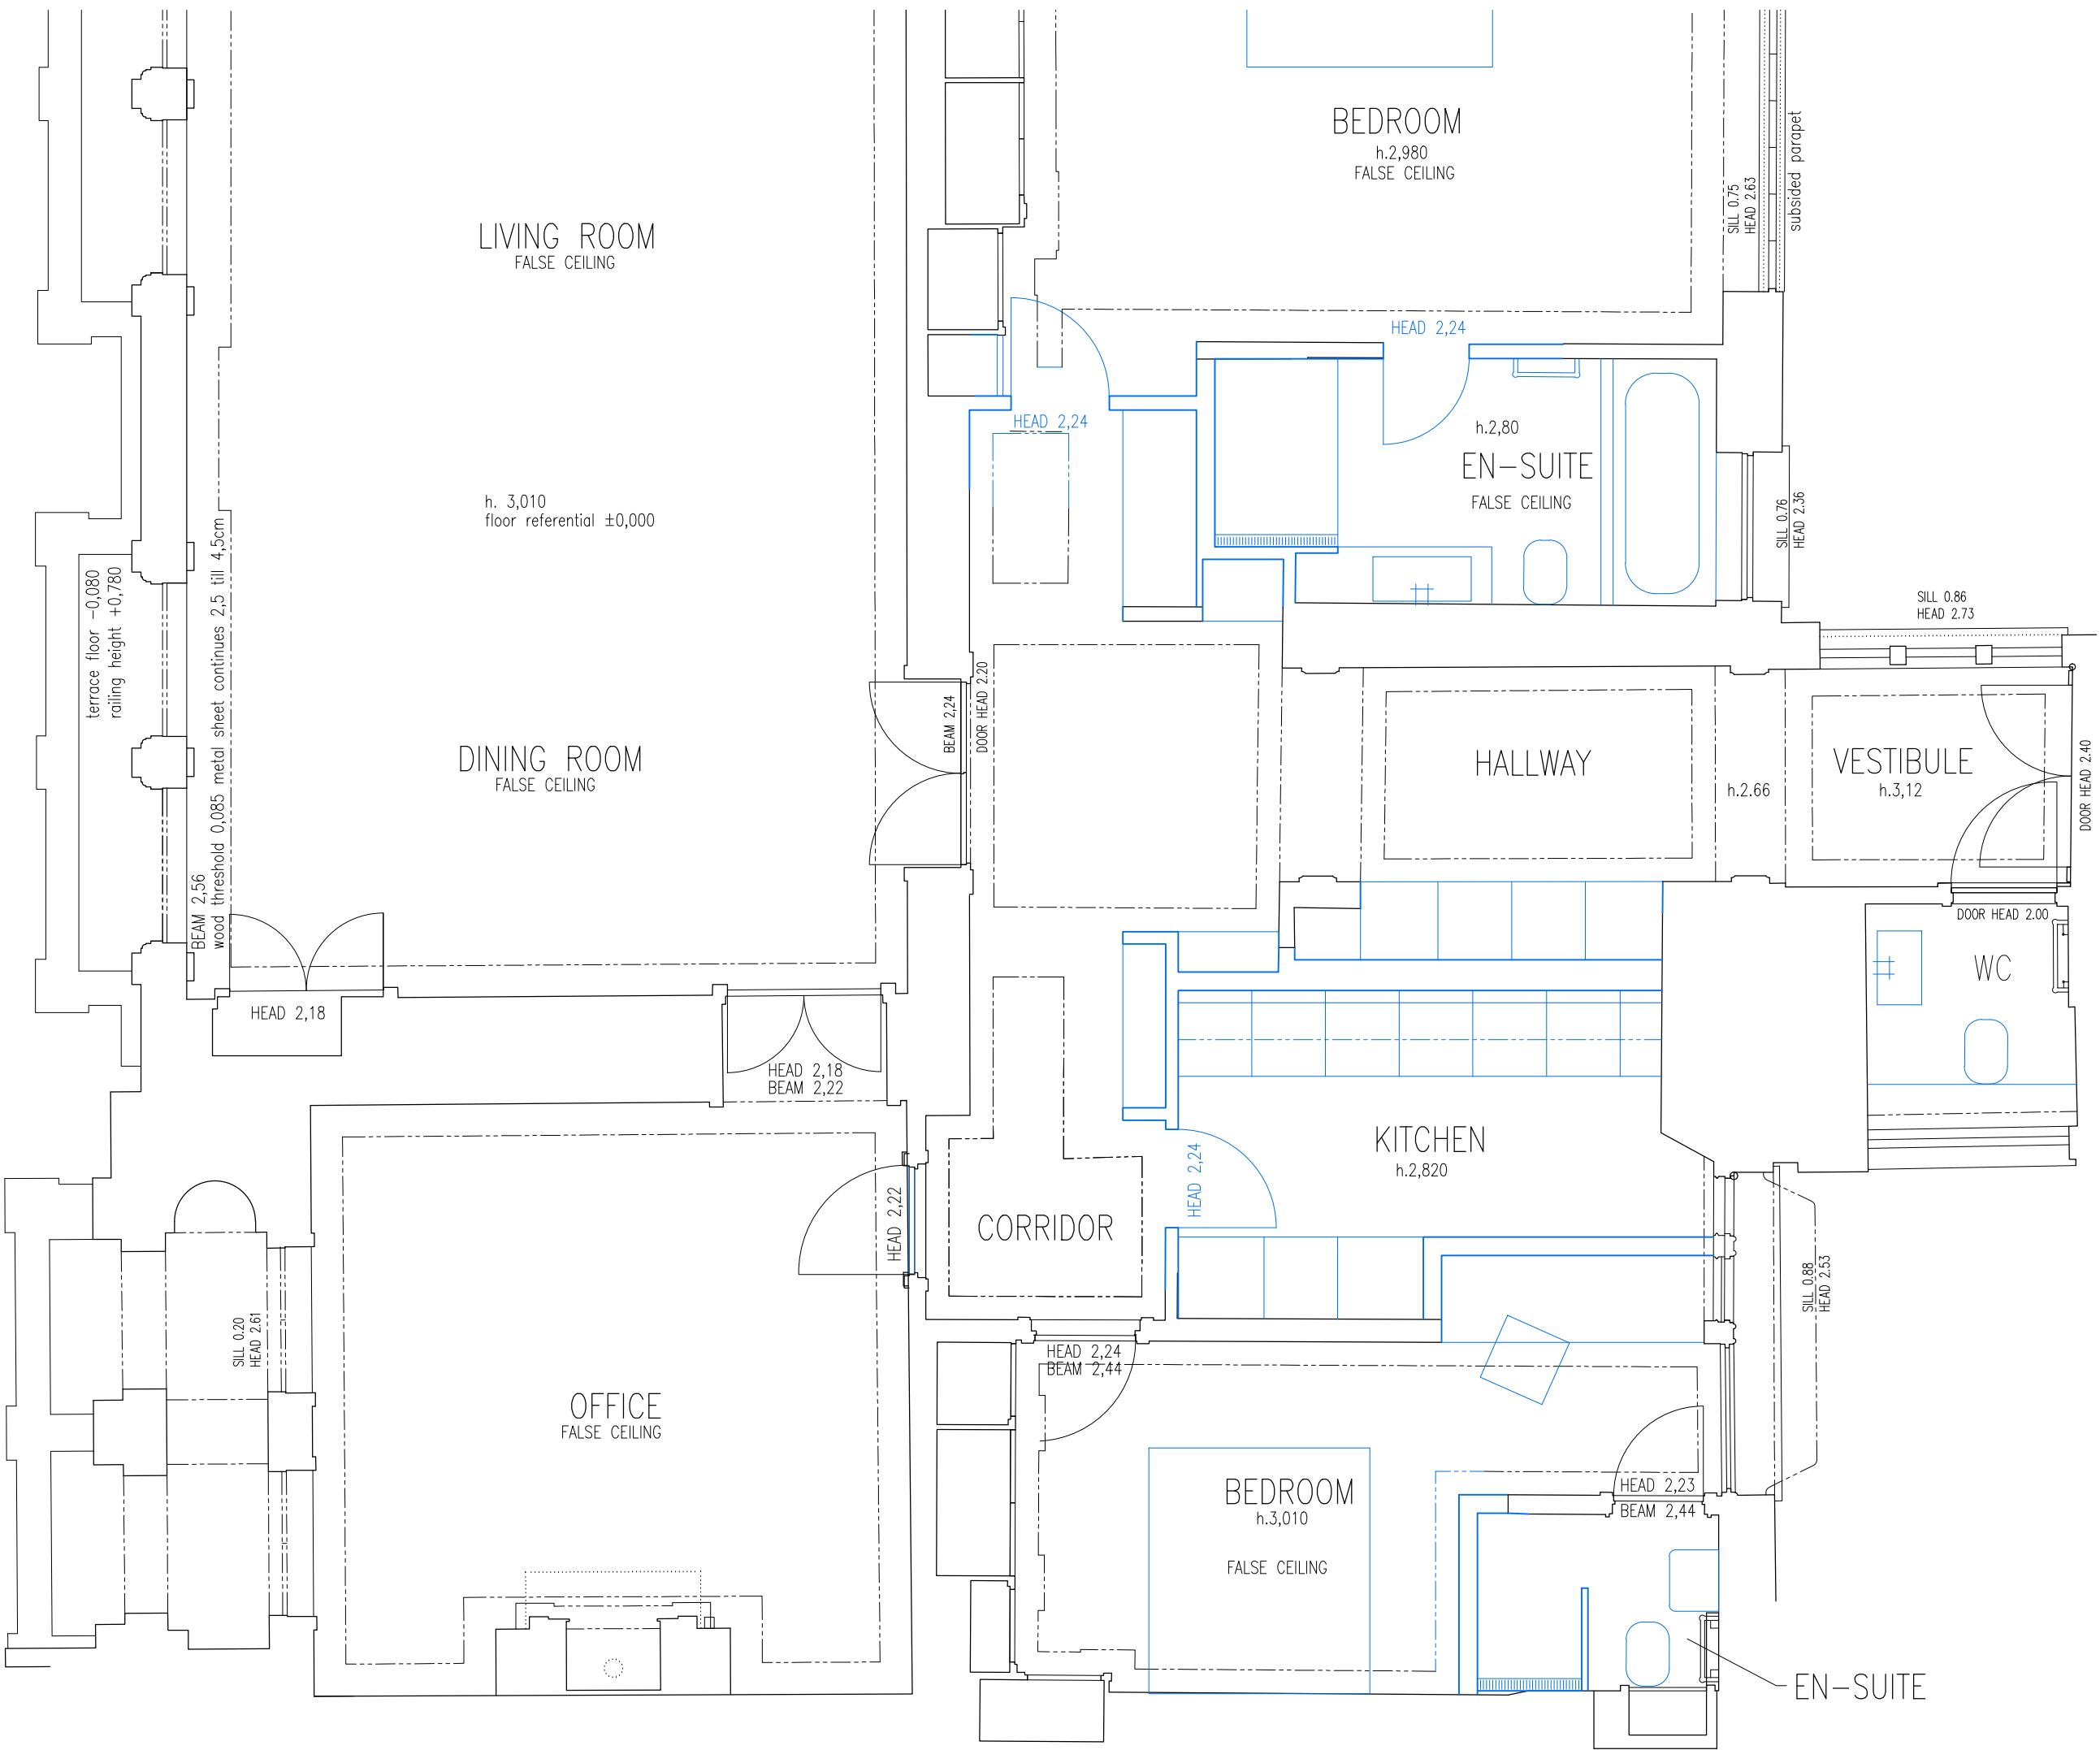

**T H E R**  
ARCHITECTURAL STUDIO

ČSA 474, CHRUDIM, 537 01  
CZECH REPUBLIC  
GSM: +420 603 807 027

CLIENT:

BUILDING:

APARTMENT No93  
WHITEHALL COURT  
LONDON

ANNEX:  
PROPOSED PLANS  
CONCEPT FLOOR PLAN  
SEGMENT

PHASE:  
CONCEPT – BUILDING DESIGN

ARCH. DESIGN:  
ING. ARCH. KAREL THÉR

PROFESSION:  
EXISTING PLANS

AUTHORIZATION:  
ING. ARCH. KAREL THÉR

DESIGNED BY:  
ĽUBLOMÍR KROV, ING. ARCH. TOMÁŠ KONDRA

DATE: 10. 2011 SET:

SCALE: 1 : 50

FORMAT: A3

DRAWING NO.:

0167-NS

PP - 110

PLAN



ELECTRICAL LEGEND

- ⊕ plug socket
- ♦ double plug socket
- ▢ TV plug
- switch 1x + dimmer
- ▢ switch 2x + dimmer
- ▢ switch 5x + dimmer
- ▢ phone socket
- ▢ wall light
- ▢ ceiling spot light
- ▢ thermostat
- ▢ sensor
- ▢ edge of ambient lighting

— edge of the ceiling strips (cornice)

T H E R  
ARCHITECTURAL STUDIO

ČSA 474, CHRUDIM, 537 01  
CZECH REPUBLIC  
GSM: +420 603 807 027

INVESTOR:

BUILDING:  
APARTMENT No93  
WHITEHALL COURT  
LONDON

ANNEX:  
EXISTING PLANS  
AS-BUILT FLOOR PLAN  
ELECTRICAL SYSTEM

PHASE:  
CONCEPT – BUILDING DESIGN

ARCH. DESIGN:  
ING. ARCH. KAREL THÉR

PROFESSION:  
EXISTING PLANS  
ARCHITECTONIC-CONSTRUCTION

AUTHORIZATION:  
ING. ARCH. KAREL THÉR

DESIGNED BY:  
KLÁRA THÉROVÁ, LUBOMÍR KROV

DATE:  
10. 2011 SET:

SCALE:  
1 : 100

FORMAT:  
A3

DRAWING NO.:  
0167-NS




AB - 150

0167-NS


AB - 150




SECTION A-A  
AS EXISTING

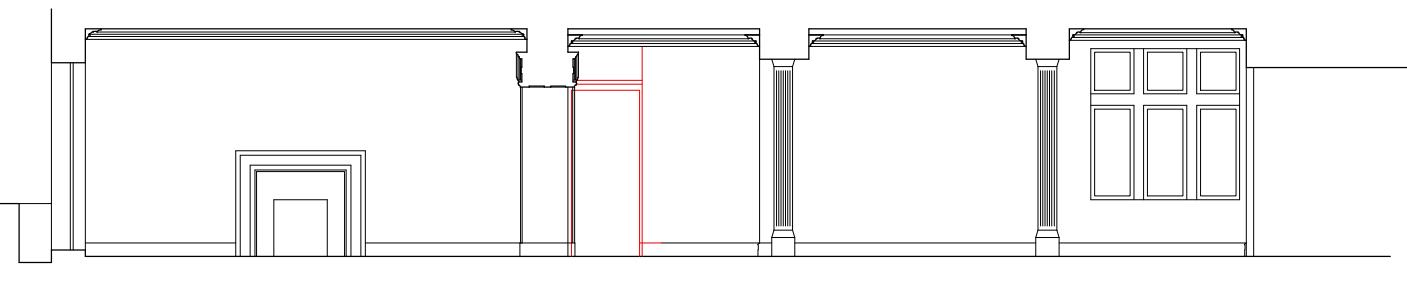


SECTION A-A  
AS PROPOSED

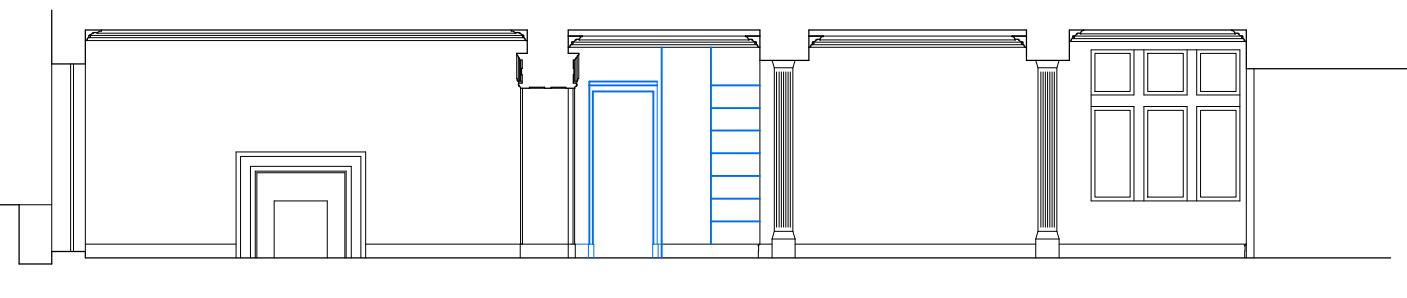

SECTION B-B  
AS EXISTING

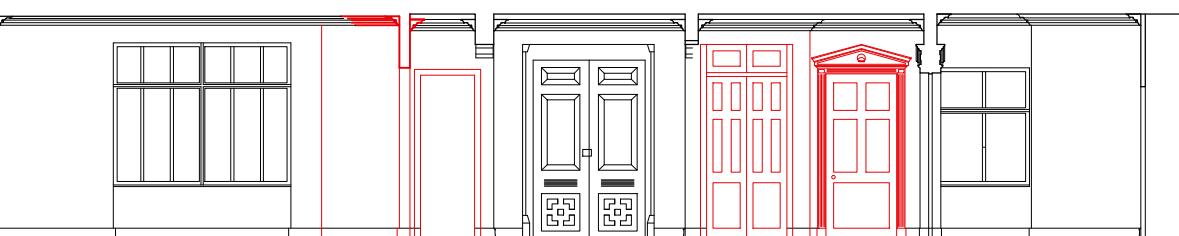

SECTION B-B  
AS PROPOSED

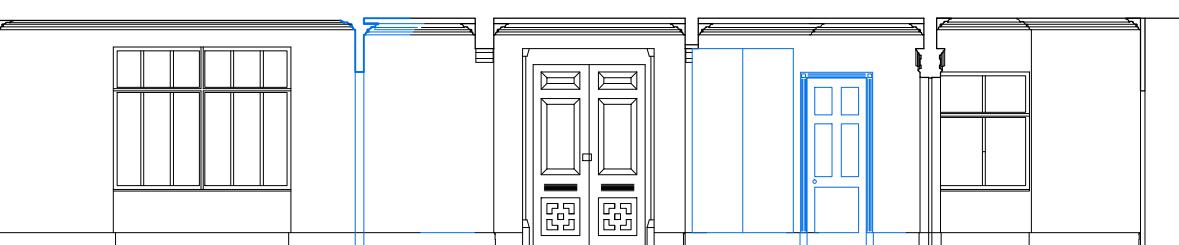

THE R  
ARCHITECTURAL STUDIO

ČSA 474, CHRUDIM, 537 01  
CZECH REPUBLIC  
GSM: +420 603 807 027

INVESTOR:

BUILDING:  
APARTMENT No93  
WHITEHALL COURT  
LONDON

ANNEX:  
SECTION A-A  
SECTION B-B

PHASE:  
CONCEPT – BUILDING DESIGN

ARCH. DESIGN:  
ING. ARCH. KAREL THÉR

PROFESSION:  
EXISTING PLANS  
ARCHITECTONIC–CONSTRUCTION

AUTHORIZATION:  
ING. ARCH. KAREL THÉR

DESIGNED BY:  
LUBOMÍR KROV, ING. ARCH. TOMÁŠ KONDRA


DATE:  
10. 2011 SET:

SCALE:  
1 : 100

FORMAT:  
A3

DRAWNING NO.:  
0167-NS

AB, PP - 200

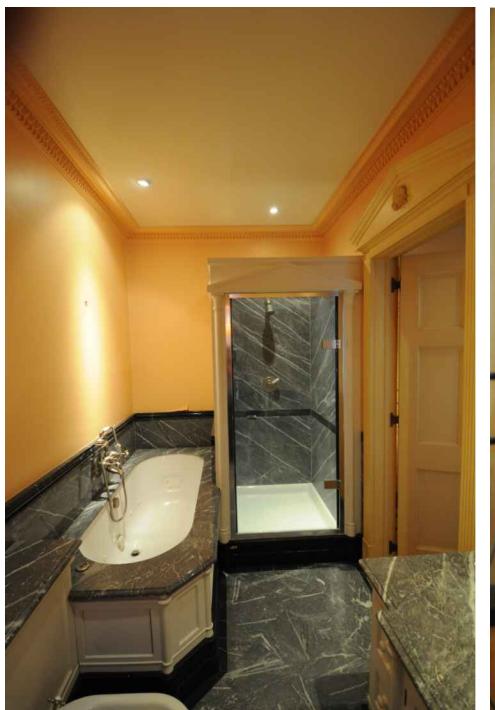

THE R  
ARCHITECTURAL STUDIO

ČSA 474, CHRUDIM, 537 01  
CZECH REPUBLIC  
GSM: +420 603 807 027

INVESTOR:

BUILDING:  
APARTMENT No93  
WHITEHALL COURT  
LONDON

ANNEX:  
EXISTING PLANS  
PHOTO DOCUMENTATION

PHASE:  
CONCEPT – BUILDING DESIGN

ARCH. DESIGN:  
ING. ARCH. KAREL THÉR

PROFESSION:  
EXISTING PLANS

AUTHORIZATION:  
ING. ARCH. KAREL THÉR

DESIGNED BY:  
ING. ARCH. TOMÁŠ KONDRA


DATE:  
10. 2011 SET:


SCALE:  
A3

FORMAT:  
A3

DRAWING NO.:  
0167-NS

AB - 600

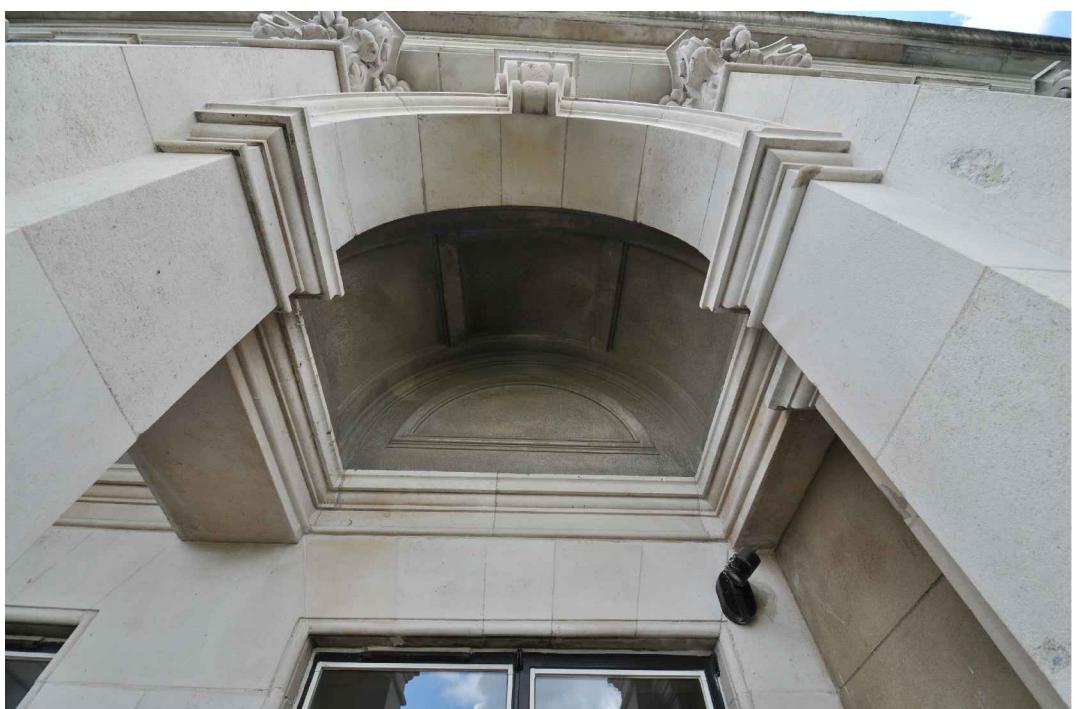

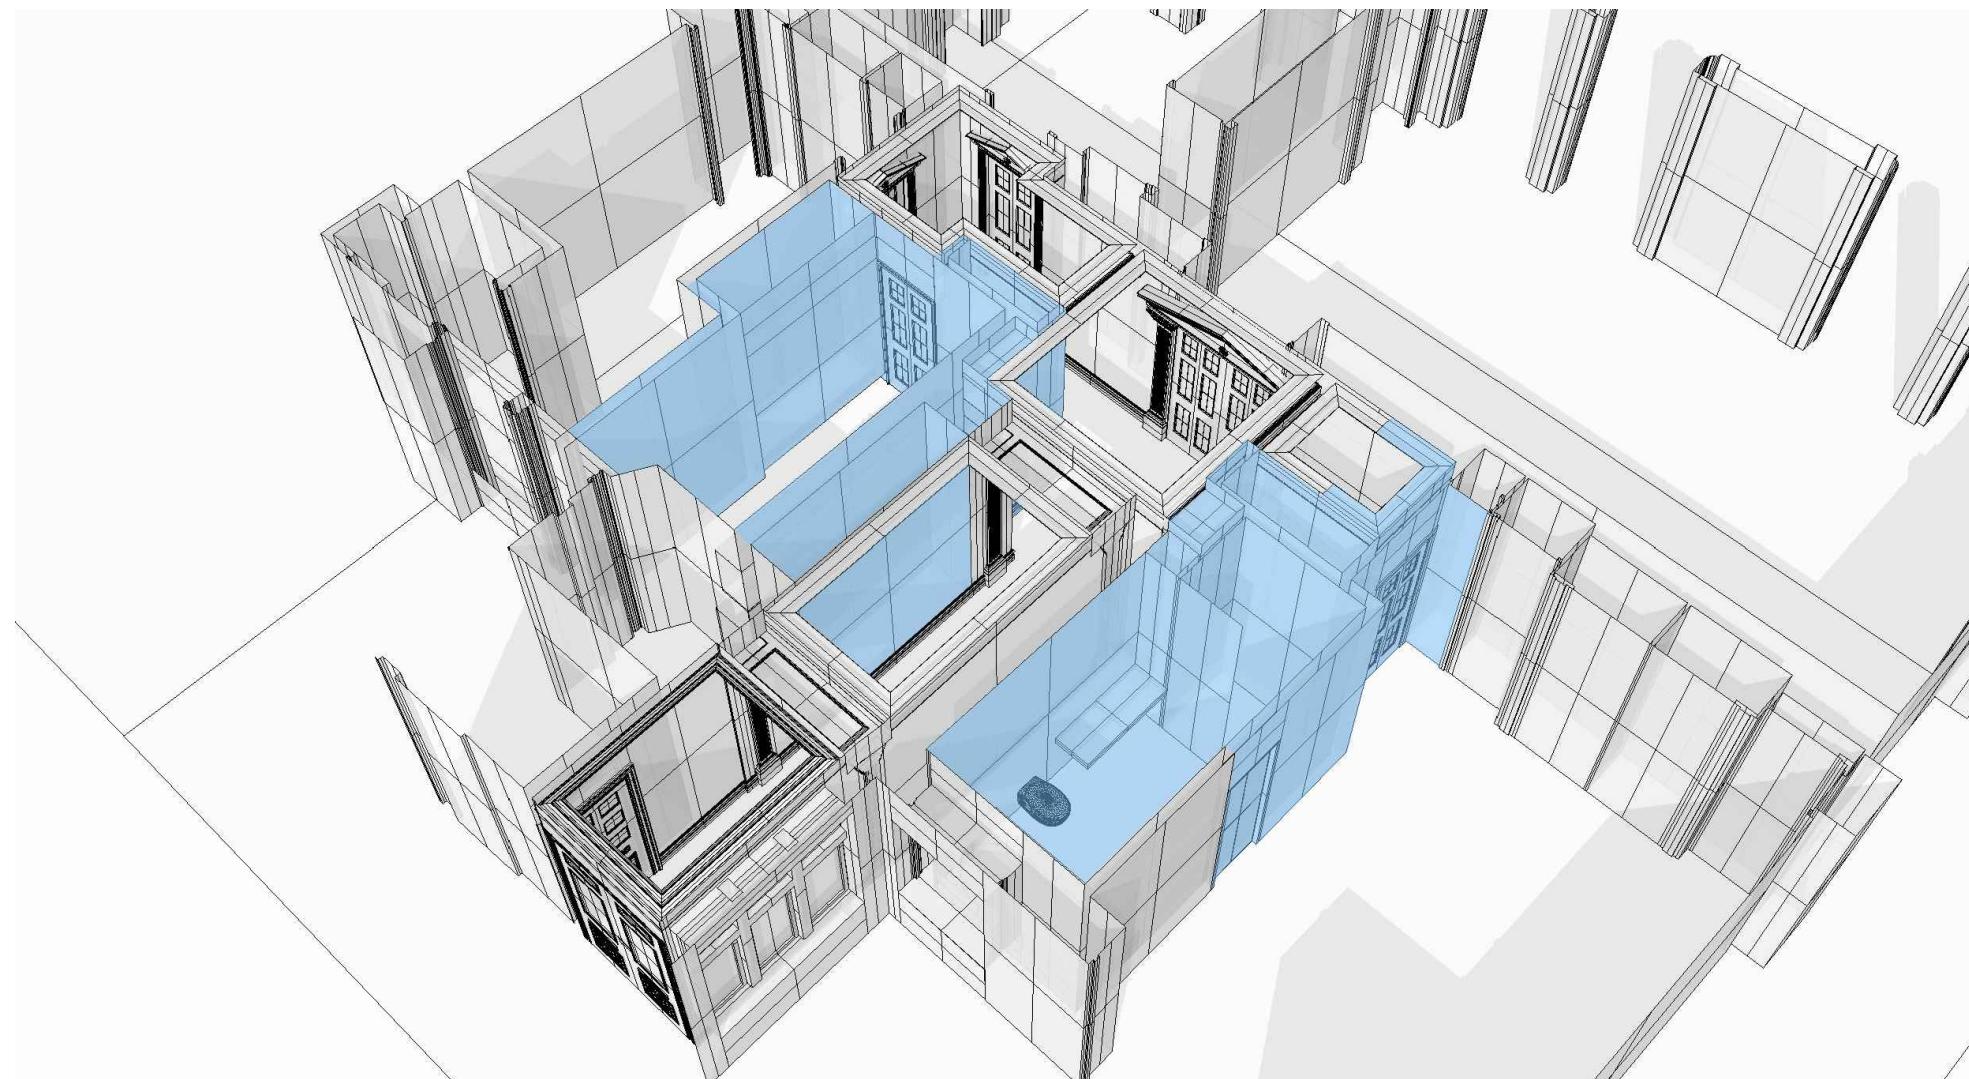

THE R  
ARCHITECTURAL STUDIO

ČSA 474, CHRUDIM, 537 01  
CZECH REPUBLIC  
GSM: +420 603 807 027

INVESTOR:

BUILDING:  
APARTMENT No93  
WHITEHALL COURT  
LONDON

ANNEX:  
PROPOSED PLANS  
CONCEPT  
VISUALIZATION

PHASE:  
CONCEPT – BUILDING DESIGN

ARCH. DESIGN:  
ING. ARCH. KAREL THÉR

PROFESSION:  
ARCHITECTONIC-CONSTRUCTION

AUTHORIZATION:  
ING. ARCH. KAREL THÉR


DESIGNED BY:  
ING. ARCH. KAREL THÉR  
ING. ARCH. TOMÁŠ KONDRA



DATE:  
10. 2011 SET:

SCALE:  
A3

FORMAT:  
A3

DRAWING NO.:  
0167-NS  
PP - 501

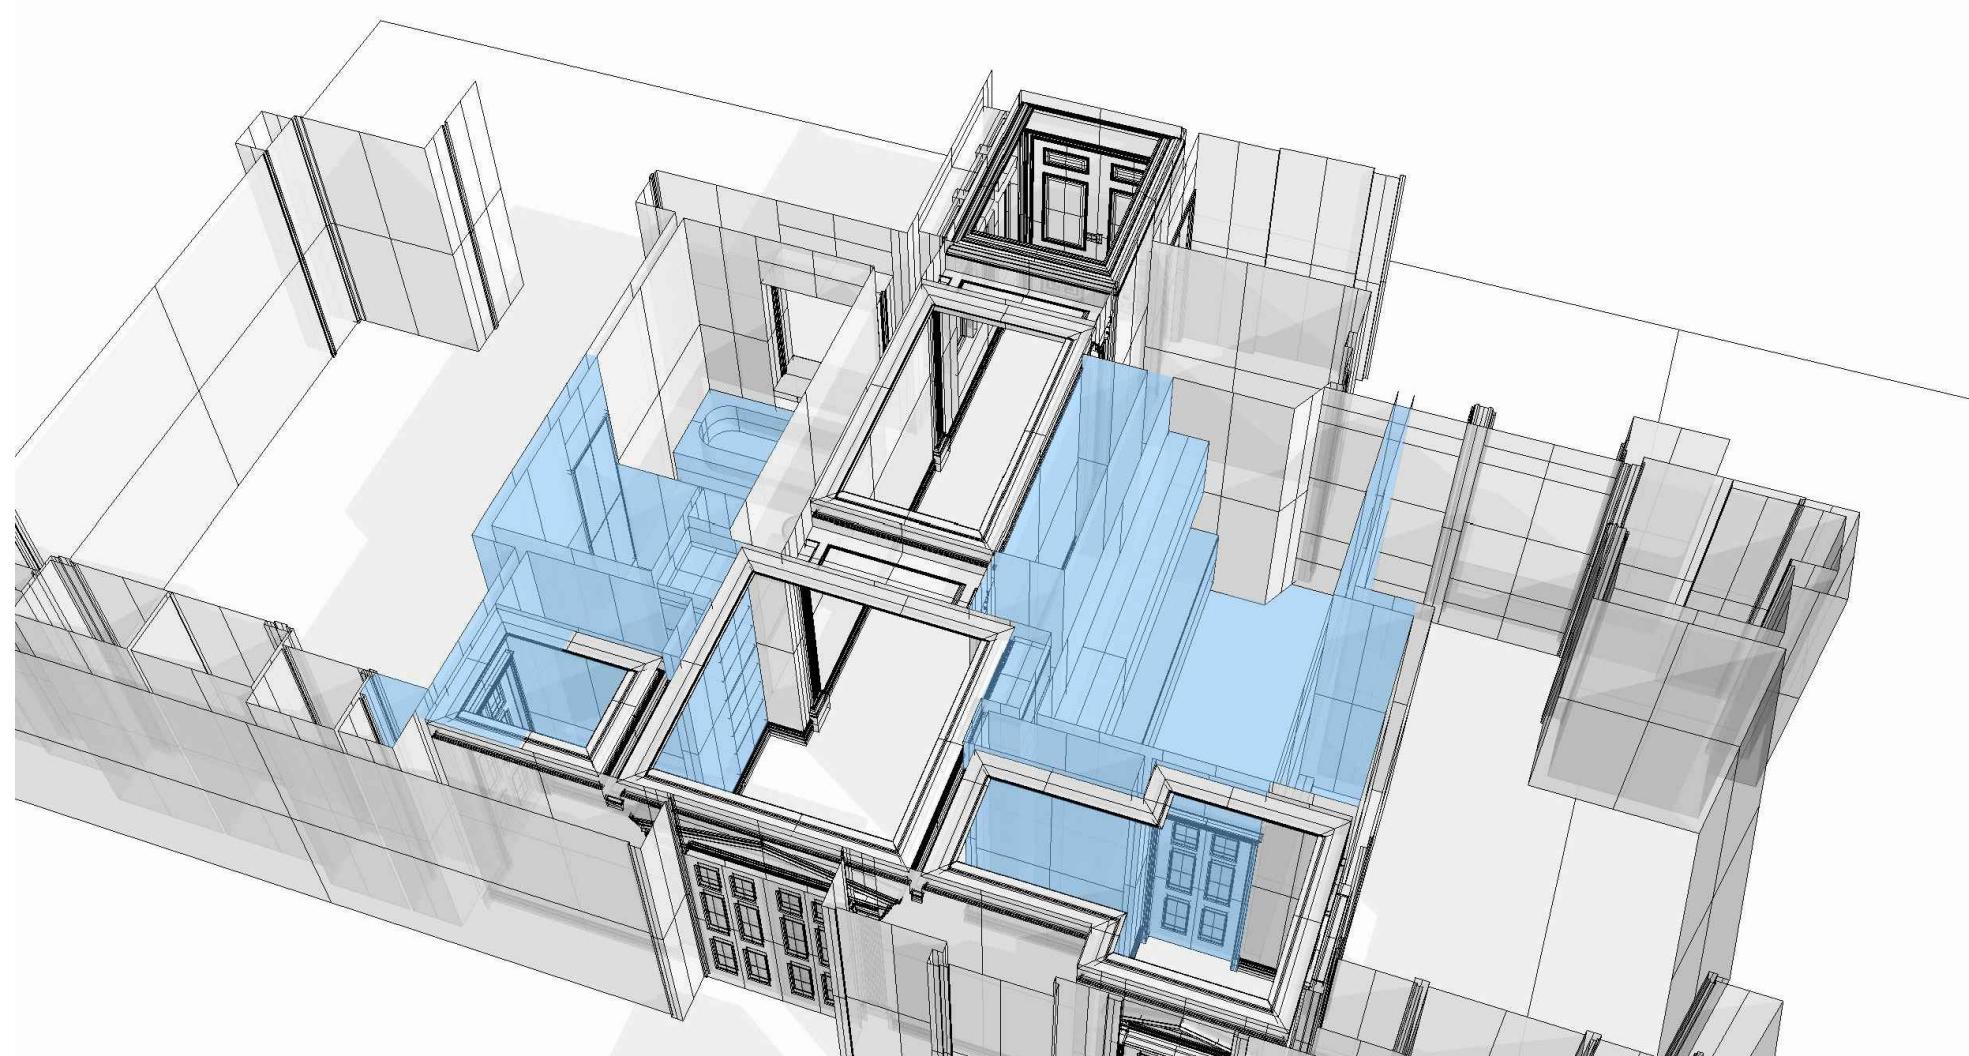

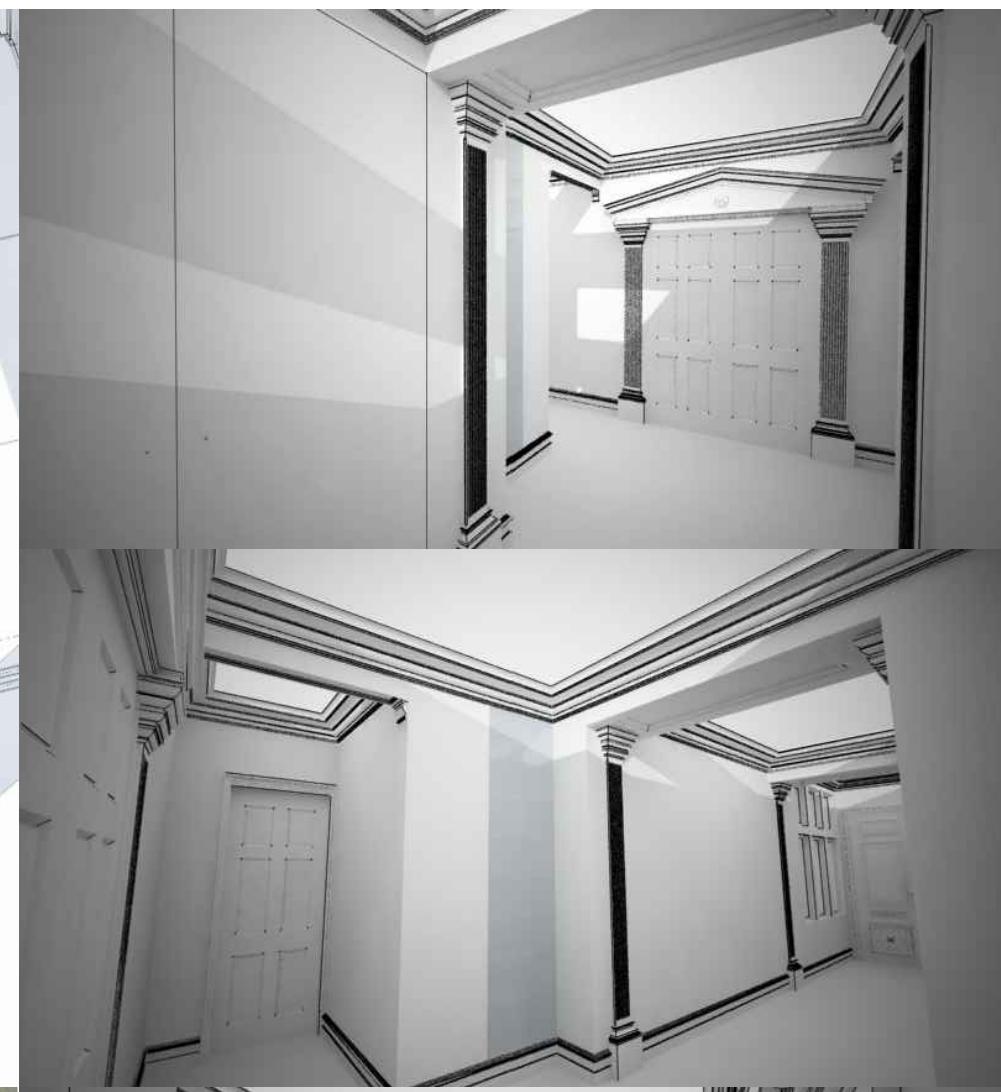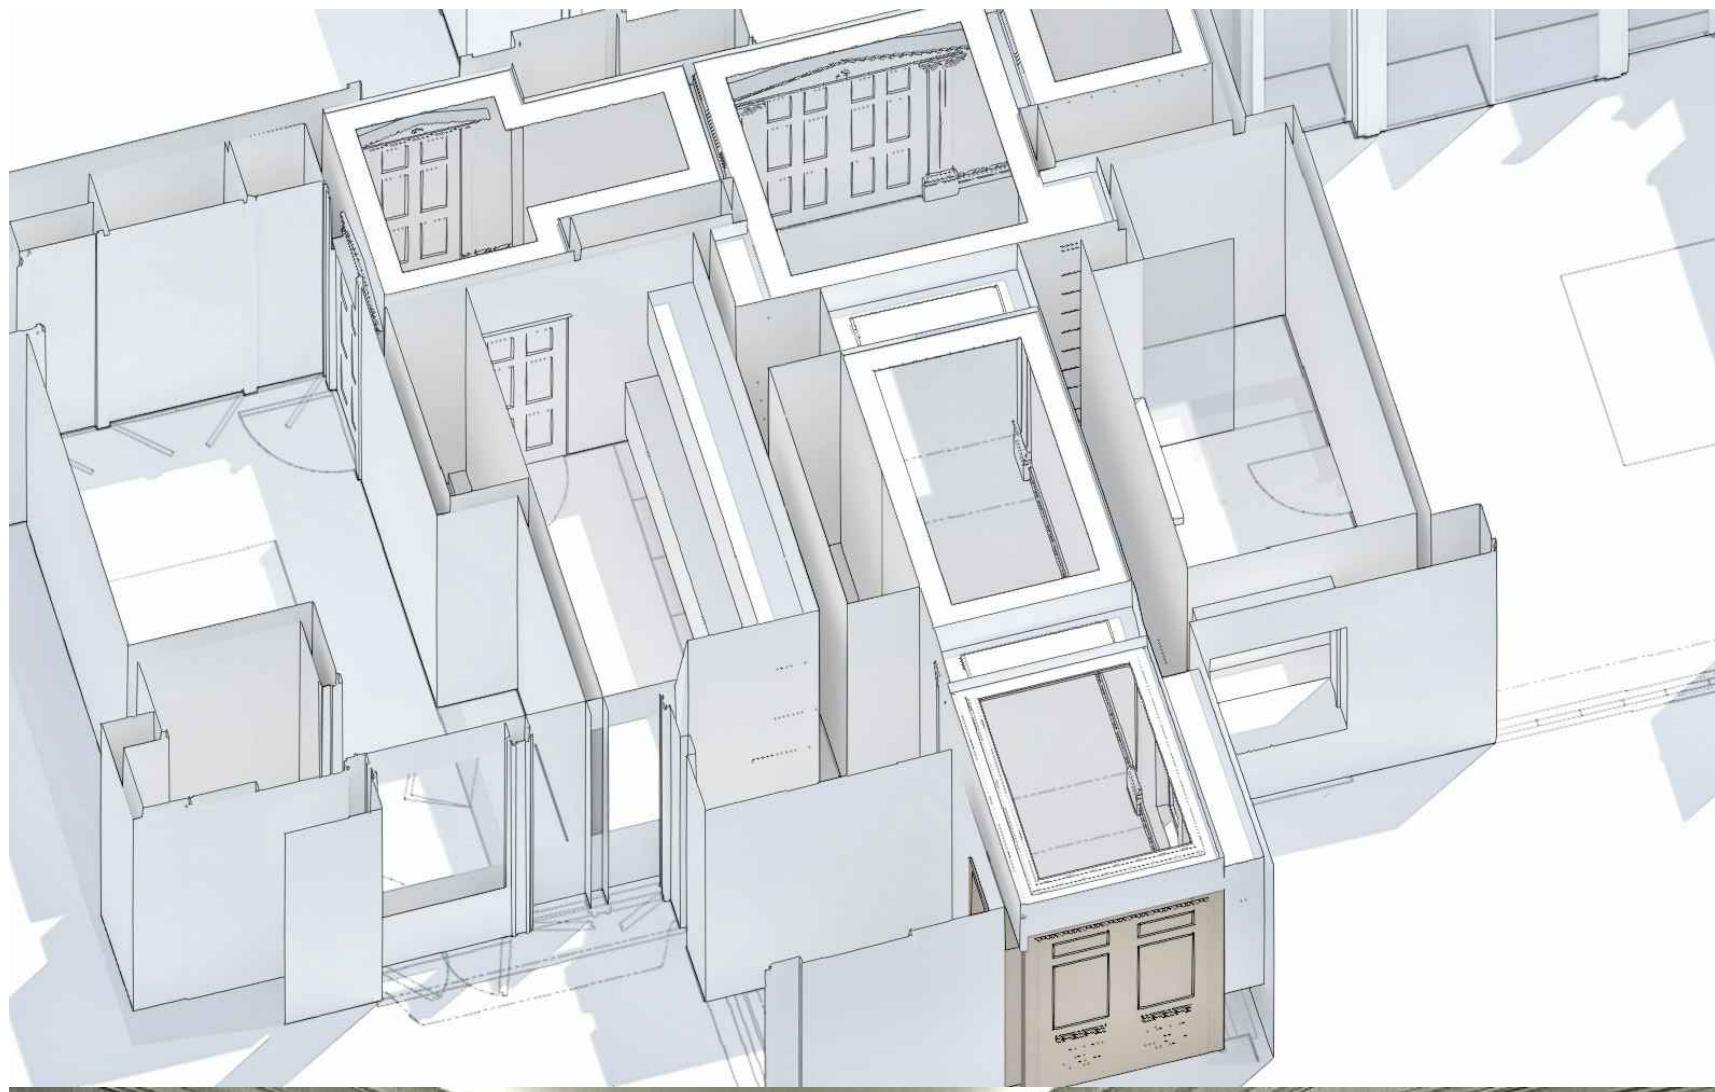

THE R  
ARCHITECTURAL STUDIO

ČSA 474, CHRUDIM, 537 01  
CZECH REPUBLIC  
GSM: +420 603 807 027

INVESTOR:

BUILDING:  
APARTMENT No93  
WHITEHALL COURT  
LONDON

ANNEX:  
PROPOSED PLANS  
CONCEPT  
VISUALIZATION

PHASE:  
CONCEPT – BUILDING DESIGN

ARCH. DESIGN:  
ING. ARCH. KAREL THÉR

PROFESSION:  
ARCHITECTONIC-CONSTRUCTION

AUTHORIZATION:  
ING. ARCH. KAREL THÉR



DESIGNED BY:  
ING. ARCH. KAREL THÉR  
ING. ARCH. TOMÁŠ KONDRA



DATE:  
10. 2011 SET:

SCALE:  
A3

FORMAT:  
0167-NS

DRAWING NO.:  
PP - 502

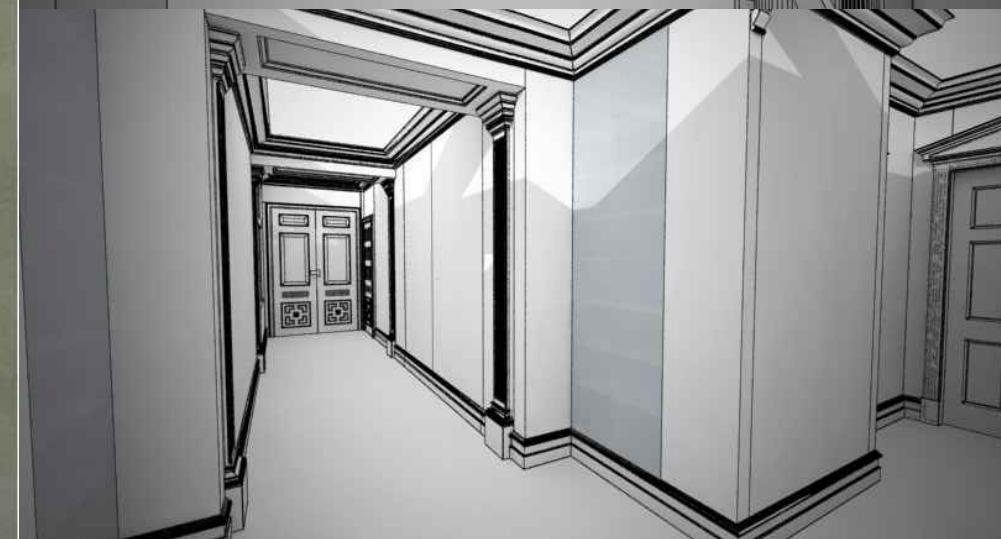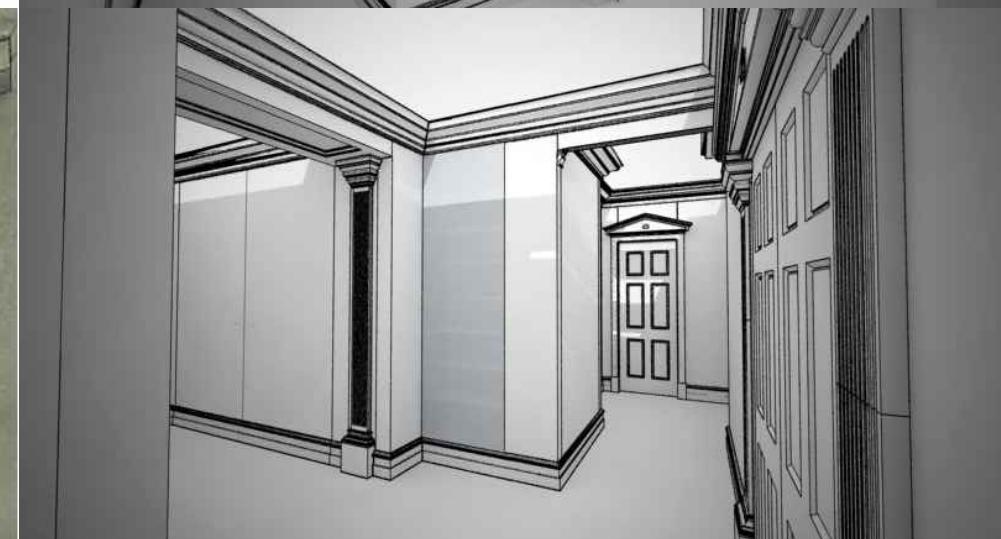

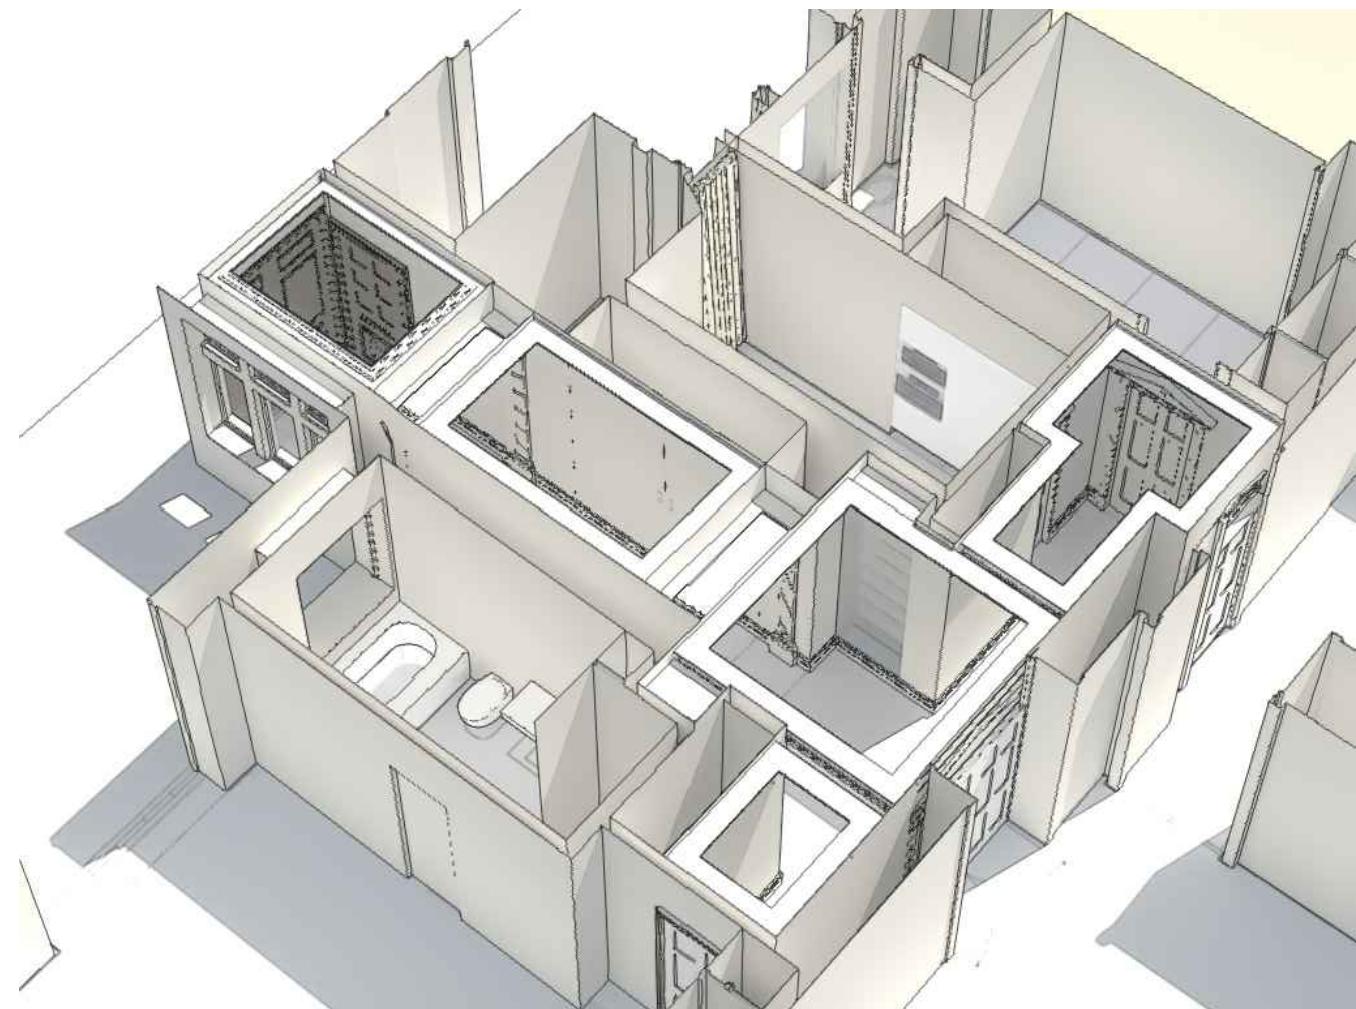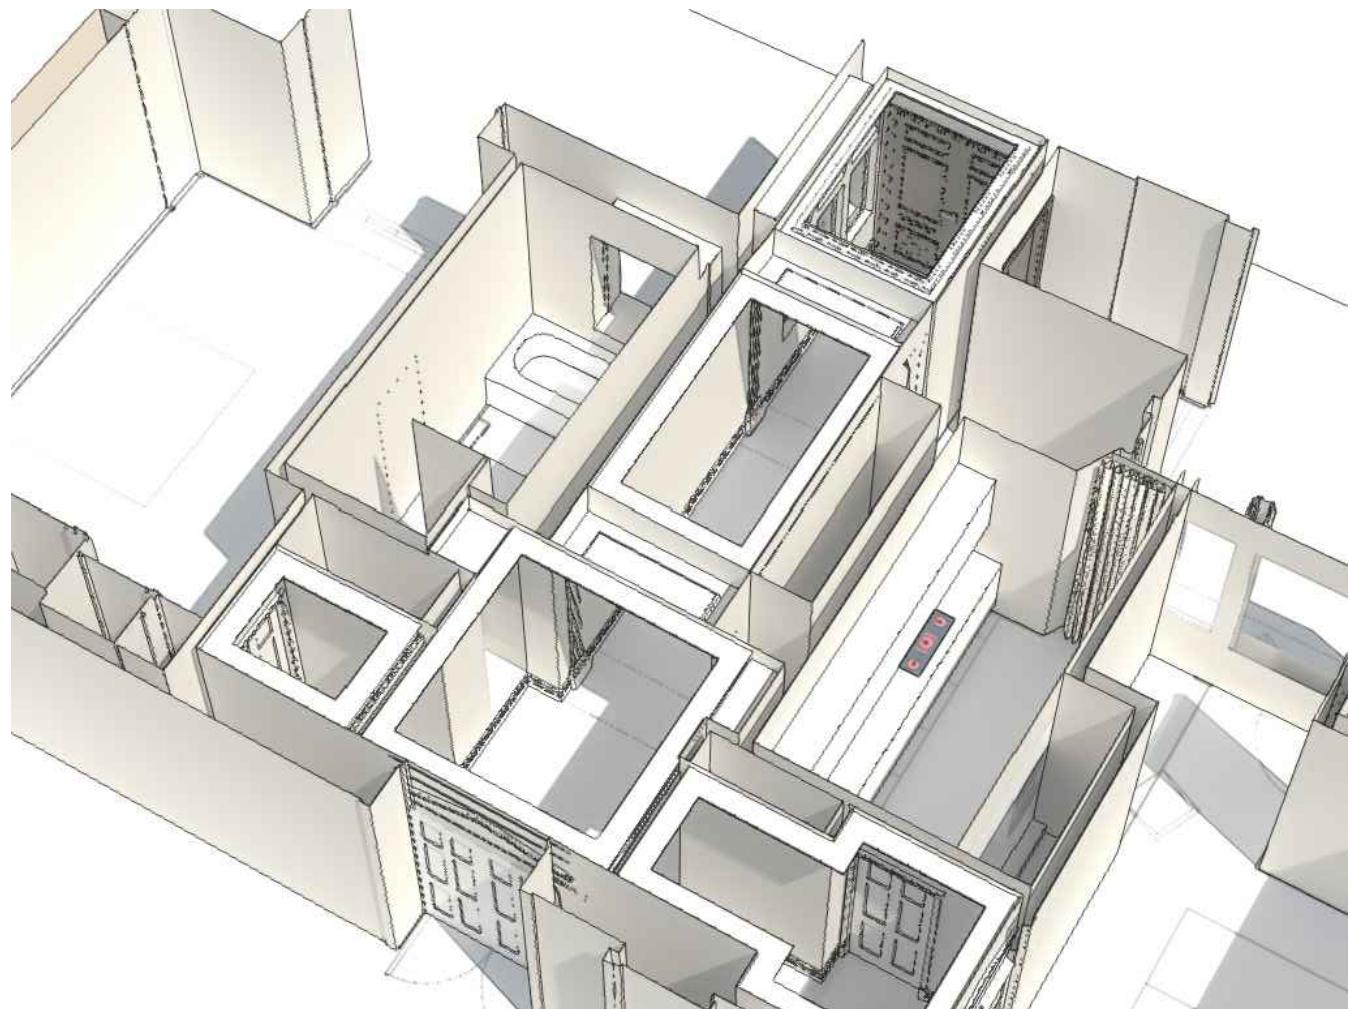

THE R  
ARCHITECTURAL STUDIO

ČSA 474, CHRUDIM, 537 01  
CZECH REPUBLIC  
GSM: +420 603 807 027

INVESTOR:

BUILDING:  
APARTMENT No93  
WHITEHALL COURT  
LONDON

ANNEX:  
PROPOSED PLANS  
CONCEPT  
VISUALIZATION

PHASE:  
CONCEPT - BUILDING DESIGN

ARCH. DESIGN:  
ING. ARCH. KAREL THÉR

PROFESSION:  
ARCHITECTONIC-CONSTRUCTION

AUTHORIZATION:  
ING. ARCH. KAREL THÉR

DESIGNED BY:  
ING. ARCH. KAREL THÉR  
ING. ARCH. TOMÁŠ KONDRA



DATE:  
10. 2011 SET:


SCALE:  
A3

FORMAT:  
A3

DRAWING NO.:  
0167-NS

PP - 503

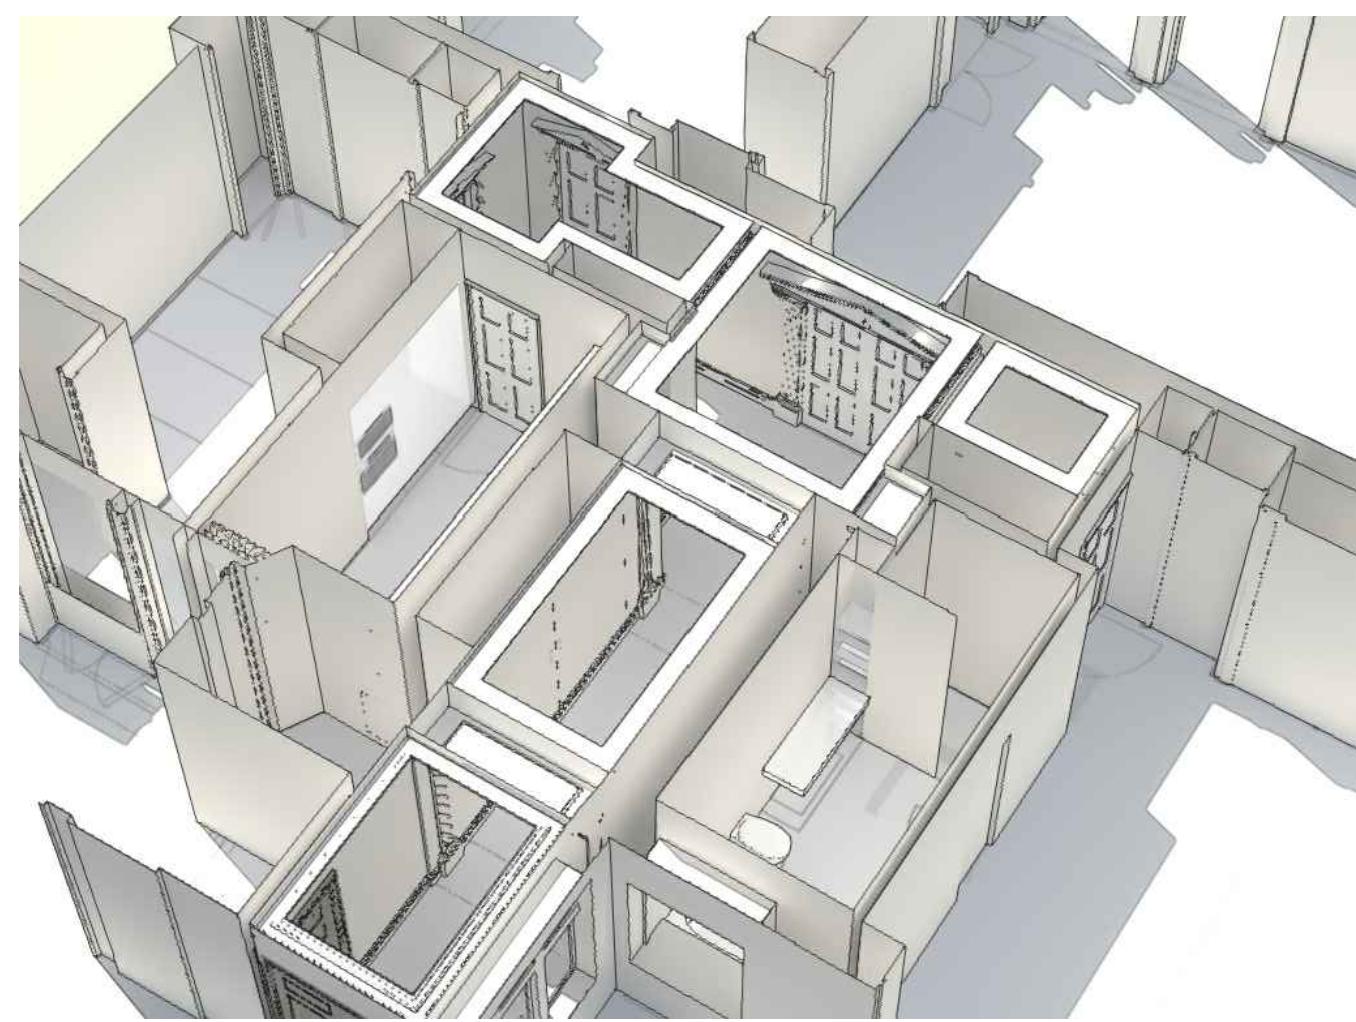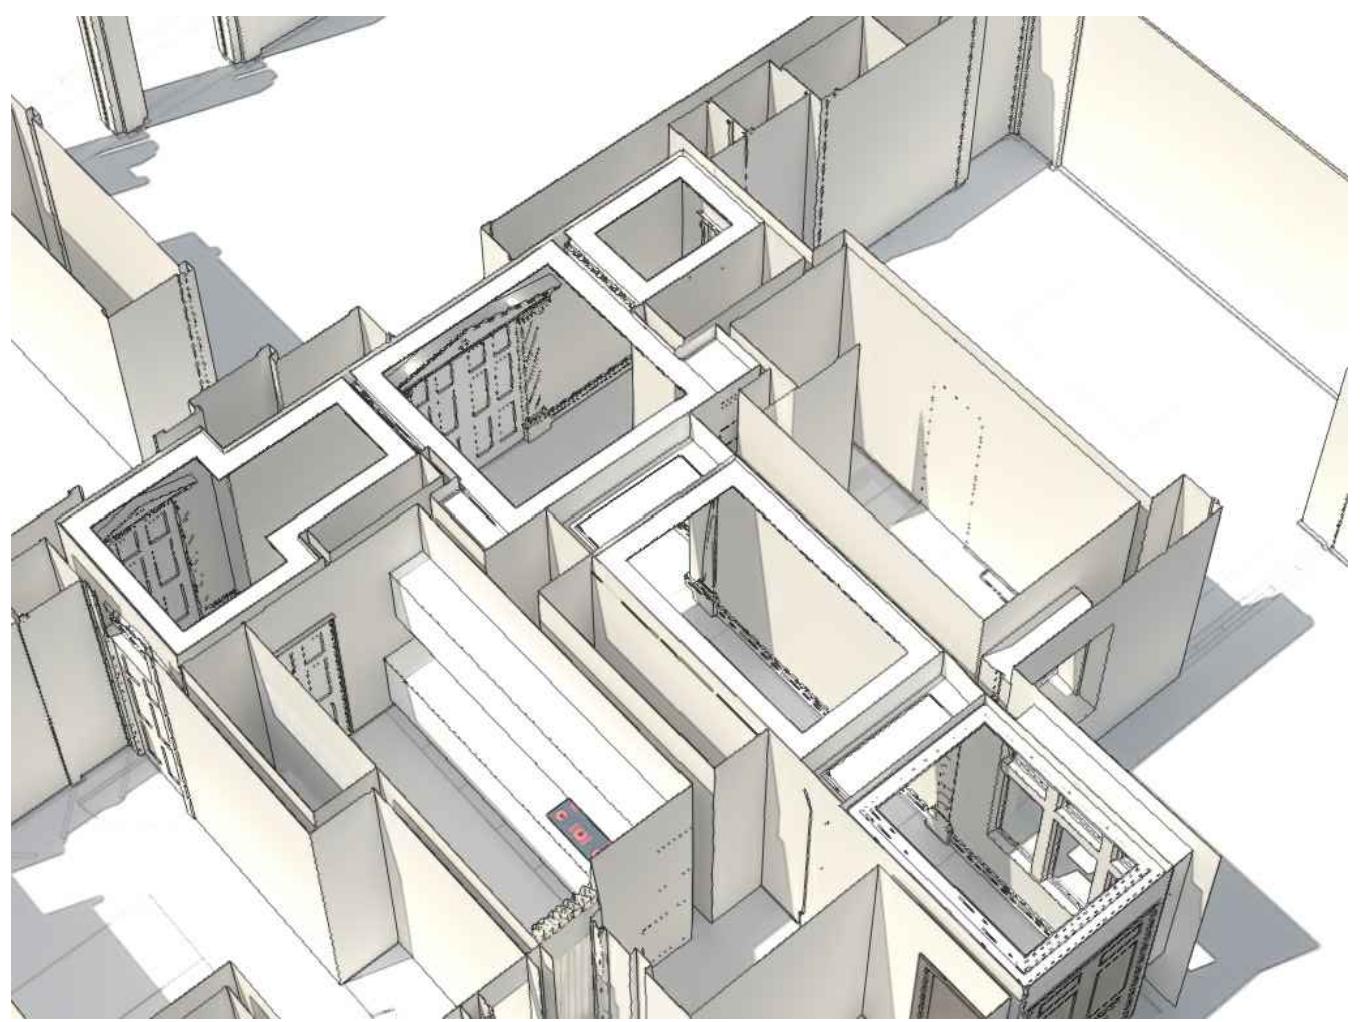

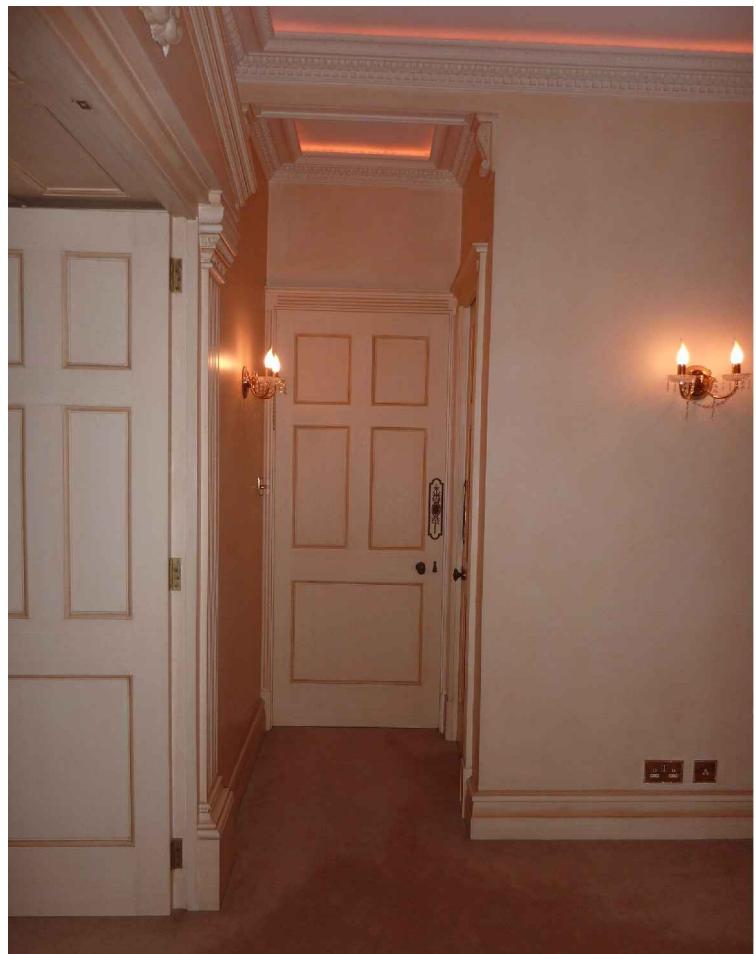

**T H E R**  
ARCHITECTURAL STUDIO

ČSA 474, CHRUDIM, 537 01  
CZECH REPUBLIC  
GSM: +420 603 807 027

INVESTOR:

BUILDING:  
**APARTMENT No93  
WHITEHALL COURT  
LONDON**

ANNEX:  
**PROPOSED PLANS  
CONCEPT  
VISUALIZATION**

PHASE:  
CONCEPT – BUILDING DESIGN

ARCH. DESIGN:  
ING. ARCH. KAREL THÉR

PROFESSION:  
ARCHITECTONIC-CONSTRUCTION

AUTHORIZATION:  
ING. ARCH. KAREL THÉR

DESIGNED BY:  
ING. ARCH. KAREL THÉR  
ING. ARCH. TOMÁŠ KONDRA

DATE:  
10. 2011 SET:

SCALE:  
A3

FORMAT:  
A3

DRAWNING NO.:  
**0167-NS**

**PP - 504**



THE R  
ARCHITECTURAL STUDIO

ČSA 474, CHRUDIM, 537 01  
CZECH REPUBLIC  
GSM: +420 603 807 027

INVESTOR:

BUILDING:  
APARTMENT No93  
WHITEHALL COURT  
LONDON

ANNEX:  
PROPOSED PLANS  
CONCEPT  
VISUALIZATION

PHASE:  
CONCEPT – BUILDING DESIGN

ARCH. DESIGN:  
ING. ARCH. KAREL THÉR

PROFESSION:  
ARCHITECTONIC-CONSTRUCTION

AUTHORIZATION:  
ING. ARCH. KAREL THÉR

DESIGNED BY:  
ING. ARCH. KAREL THÉR  
ING. ARCH. TOMÁŠ KONDRA


DATE:  
10. 2011 SET:

SCALE:

FORMAT:  
A3

DRAWNING NO.:  
0167-NS

PP - 505

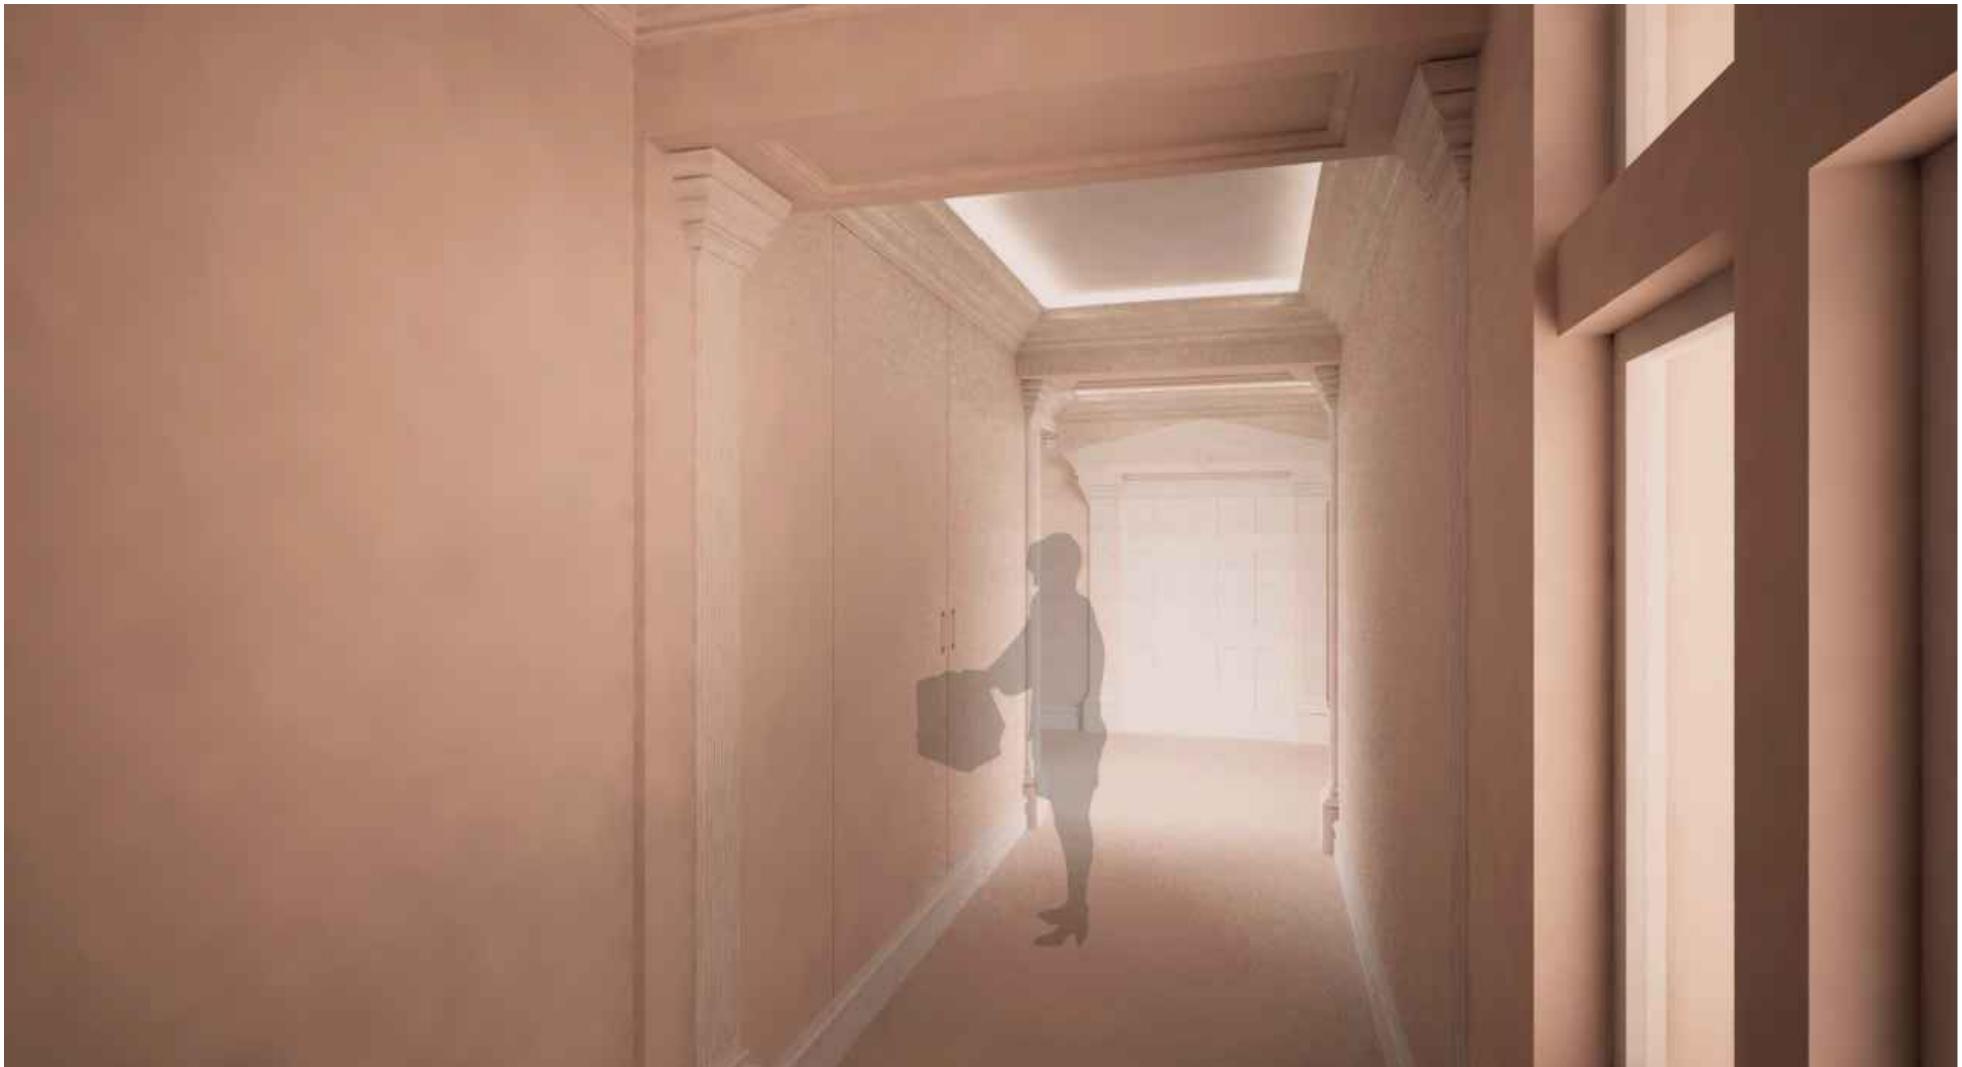

THE R  
ARCHITECTURAL STUDIO

ČSA 474, CHRUDIM, 537 01  
CZECH REPUBLIC  
GSM: +420 603 807 027

INVESTOR:

BUILDING: APARTMENT No93  
WHITEHALL COURT  
LONDON

ANNEX: PROPOSED PLANS  
CONCEPT  
VISUALIZATION

PHASE: CONCEPT – BUILDING DESIGN

ARCH. DESIGN: ING. ARCH. KAREL THÉR

PROFESSION: ARCHITECTONIC-CONSTRUCTION

AUTHORIZATION: ING. ARCH. KAREL THÉR

DESIGNED BY: ING. ARCH. KAREL THÉR  
ING. ARCH. TOMÁŠ KONDRA


DATE: 10. 2011 SET:




SCALE:

FORMAT: A3

DRAWNING NO.: 0167-NS

PP - 506

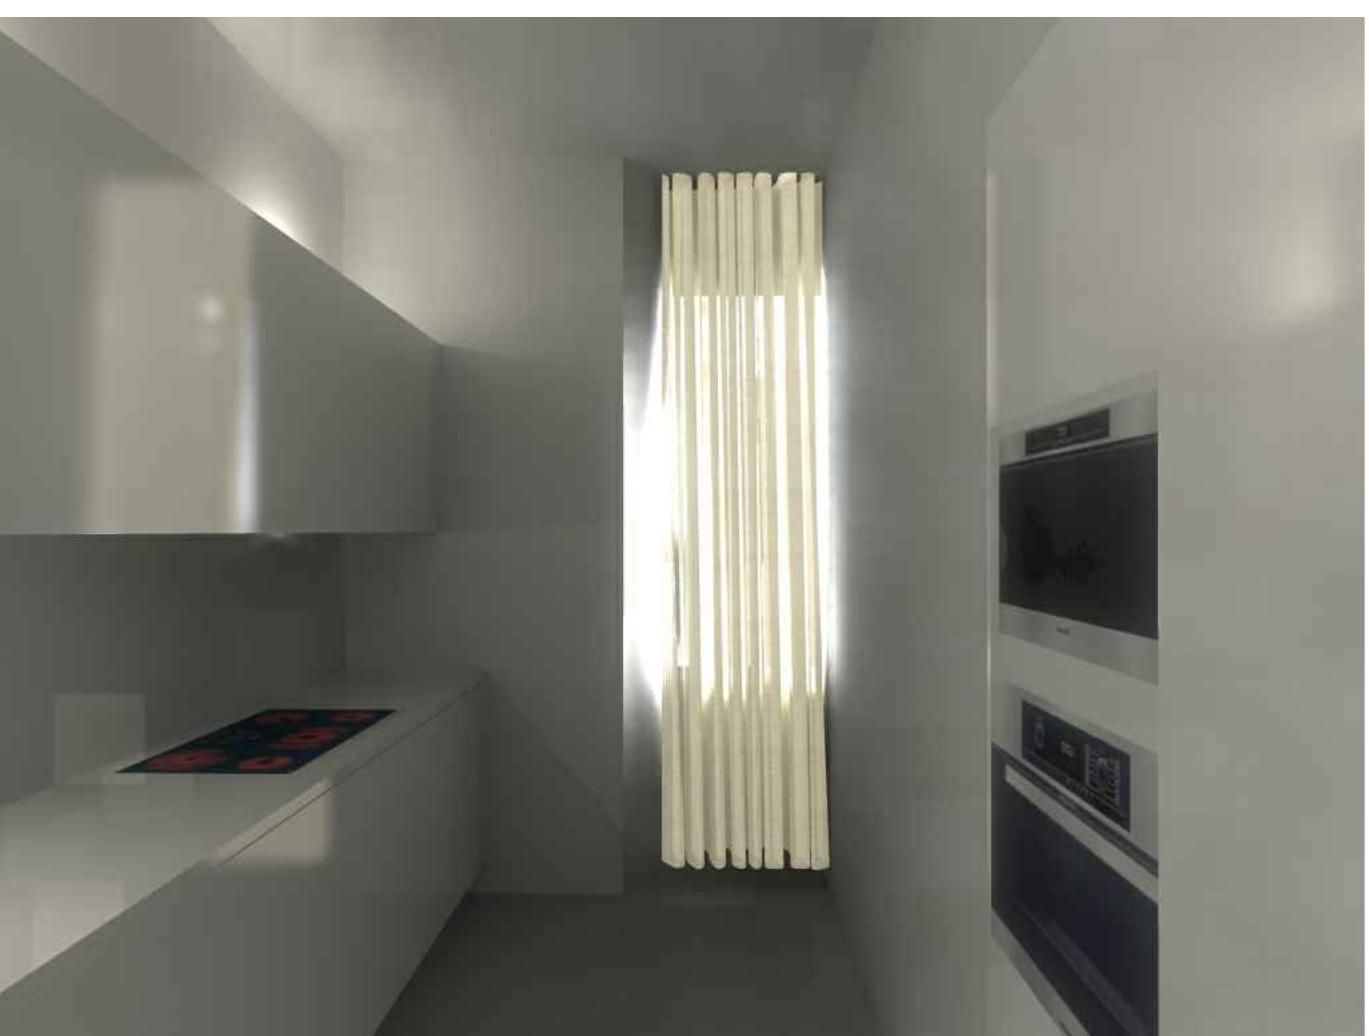

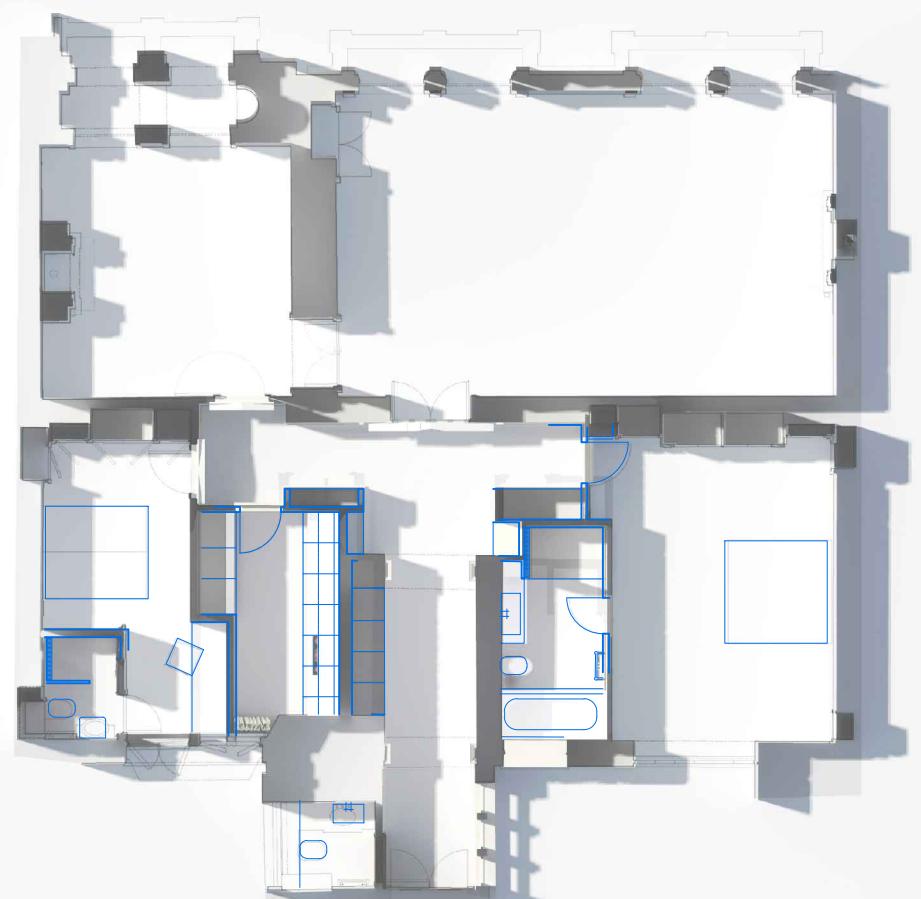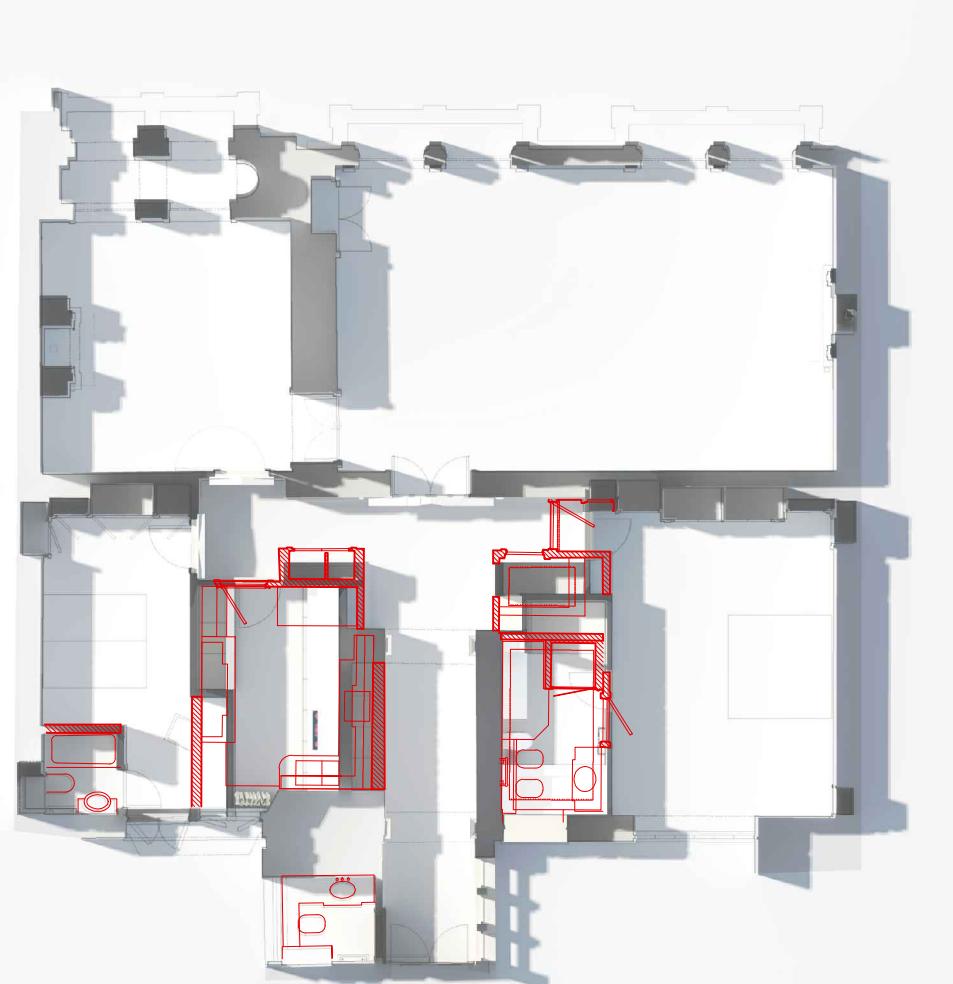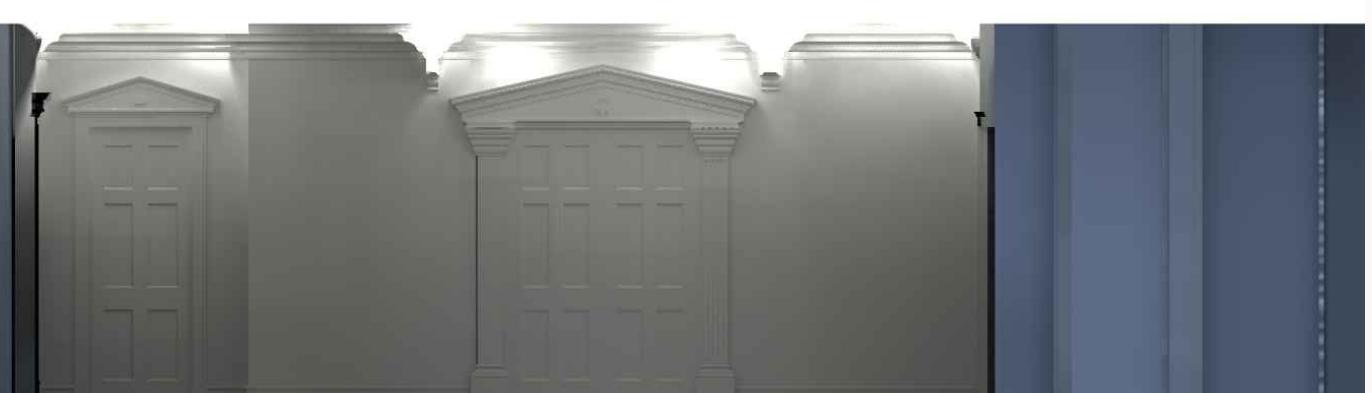

THE R  
ARCHITECTURAL STUDIO

ČSA 474, CHRUDIM, 537 01  
CZECH REPUBLIC  
GSM: +420 603 807 027

INVESTOR:

BUILDING:  
APARTMENT No93  
WHITEHALL COURT  
LONDON

ANNEX:  
PROPOSED PLANS  
CONCEPT  
VISUALIZATION

PHASE:  
CONCEPT - BUILDING DESIGN

ARCH. DESIGN:  
ING. ARCH. KAREL THÉR

PROFESSION:  
ARCHITECTONIC-CONSTRUCTION

AUTHORIZATION:  
ING. ARCH. KAREL THÉR

DESIGNED BY:  
ING. ARCH. KAREL THÉR  
ING. ARCH. TOMÁŠ KONDRA

DATE:  
10. 2011 SET:

SCALE:

FORMAT:  
A3

DRAWING NO.:  
0167-NS

PP - 507